

Pike
 D141
 4-12-72

MISSISSIPPI
 BOARD OF WATER COMMISSIONERS
 416 North State Street
 Jackson, Mississippi 39201

CODED

WATER WELL DRILLERS LOG

4-12 1972
 date well completed

Fitzgerald Well Co
 firm name

Pike
 county well located

LANDOWNER:	description of formations encountered	from	to
Donald Brewer P.O. Box 116 (mailing address)	Red Clay Red gravel Coarse sand & gravel	0 20 80	20 80 112
WELL LOCATION: sec. 3 T 3 N R 7 E 1 miles W of Merib (distance) (direction) (nearest town)			
WELL PURPOSE: (home, irrigation, municipal, industrial)			
WELL COMPLETION DATA: (1) diameter (inches) 4 (2) total depth (feet) 112 (3) static water level (feet) 35 below above top of ground. (4) casing Plastic 104. (material) (depth) 4 (size) if telescope see back. (5) screen 8, 104 (length) (depth to top) 4 (size) Plastic (material) (6) pump 1 25 (HP) (yield gpm) Clear (type power) (7) electric log no (yes or no) (organization running log)			
(8) how well bottom plugged Wood plug			
DRILLERS REMARKS:			

CODED


APR 27 1972

MISS. Bd. of
 WATER COMMISSIONERS

If well telescopes please sketch and show depths.

GROUND LEVEL

CODDED

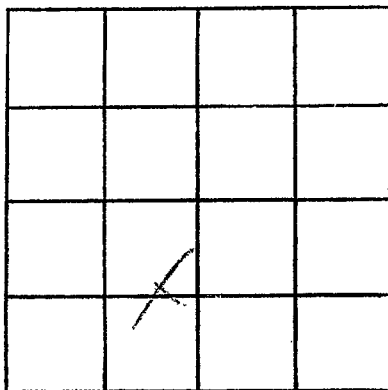

SECTION 3

Please indicate well location X.

ADDITIONAL INFORMATION

Series of horizontal lines for additional information.

If more than one screen, show locations of each on sketch.