

Pike
D142
4-1-72

MISSISSIPPI
BOARD OF WATER COMMISSIONERS
416 North State Street
Jackson, Mississippi 39201

CODED

WATER WELL DRILLERS LOG

1 April 1972 J-T Corporation Pike
date well completed firm name county well located

LANDOWNER:	description of formations encountered	from	to
Herbert Beall			
M. Comb. (mailing address)	Clay	0	10
WELL LOCATION:	Red Sand	10	35
sec. 32 T ³ N R 7 E	Sand	35	70
4 miles west of Mclamb (distance) (direction) (nearest town)	Chalk	70	85
WELL PURPOSE: (home, irrigation, municipal, industrial)	Sand	85	127
WELL COMPLETION DATA:			
(1) diameter (inches) 4			
(2) total depth (feet) 127			
(3) static water level (feet) 45 below top of ground.			
(4) casing (material) PL (depth) 121			
(size) if telescope see back.			
(5) screen (length) 6 (depth to top) 121			
(size) PL (material)			
(6) pump 1/2 (HP) 8 (yield gpm)			
(type power) electric			
(7) electric log (yes or no)			
(organization running log)			
(8) how well bottom plugged wood			
DRILLERS REMARKS:			


CODED

APR 1 1972

MISSISSIPPI BOARD OF WATER COMMISSIONERS
416 NORTH STATE STREET
JACKSON, MISSISSIPPI 39201

If well telescopes please sketch and show depths.

GROUND LEVEL

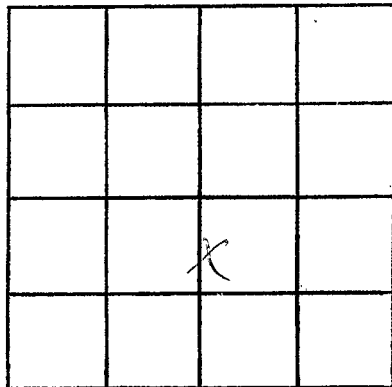

SECTION 32

Please indicate well location X.

ADDITIONAL INFORMATION

If more than one screen, show locations of each on sketch.