

MISSISSIPPI
 BOARD OF WATER COMMISSIONERS
 416 North State Street
 Jackson, Mississippi 39201

WATER WELL DRILLERS LOG

CODED

Pike
 D 143
 4-20-72

date well completed April 19, 72 firm name Chester Keever county well located Pike

LANDOWNER: J. Myers Jr.
Rt 3, Summit
 (mailing address)

WELL LOCATION:
 sec. 19 T. 3 N. R. 7 E
5 miles West McComb
 (distance) (direction) (nearest town)

WELL PURPOSE: Home
 (home, irrigation, municipal, industrial)

- WELL COMPLETION DATA:
- (1) diameter (inches) 4"
 - (2) total depth (feet) 85
 - (3) static water level (feet) 46 below top of ground.
 - (4) casing Plast Bottom
 (material) (depth)
 - (5) screen 6' 79'
 (length) (depth to top)
 - (6) pump 4" Plast
 (size) (material)
 - (7) pump 1/2 HP 15
 (HP) (yield gpm)
 - (8) electric log No
 (yes or no)

(organization running log)

(8) how well bottom plugged
wooden plug

DRILLERS REMARKS:
New house

description of formations encountered	from	to
<u>red clay</u>	<u>0</u>	<u>10</u>
<u>clay & gravel</u>	<u>10</u>	<u>27</u>
<u>red sand & gravel</u>	<u>27</u>	<u>72</u>
<u>white sand & gravel</u>	<u>72</u>	<u>85</u>


CODED

APR 20 1972

MISS. BUREAU OF WATER RESOURCES

If well telescopes please sketch and show depths.

GROUND LEVEL

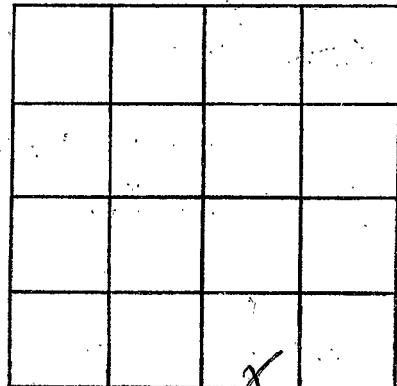

SECTION 19

Please indicate well location X.

ADDITIONAL INFORMATION

If more than one screen, show locations of each on sketch.