

Pike  
D144  
7-24-72

MISSISSIPPI  
BOARD OF WATER COMMISSIONERS  
416 North State Street  
Jackson, Mississippi 39201

WATER WELL DRILLERS LOG

**CODED**

July 24 19 72 *Lyons Well Serv.* *Pike*  
date well completed firm name county well located

LANDOWNER:	description of formations encountered	from	to
<i>Russell Shatler</i>	<i>Red clay</i>	<i>0</i>	<i>20</i>
(mailing address)	<i>Red sand</i>	<i>20</i>	<i>80</i>
WELL LOCATION: sec. <i>6</i> T. <i>30</i> N. R. <i>30</i> E <i>6</i> miles <i>W</i> of <i>McComb</i> (distance) (direction) (nearest town)	<i>Coarse sand &amp; gravel</i>	<i>80</i>	<i>102</i>
WELL PURPOSE: <i>Home</i> (home, irrigation, municipal, industrial)			
WELL COMPLETION DATA:			
(1) diameter (inches) <i>4</i>			
(2) total depth (feet) <i>102</i>			
(3) static water level (feet) <i>65</i> below above top of ground.			
(4) casing <i>Plastic</i> , <i>94</i> (material) (depth)			
<i>4</i> if telescope see back. (size)			
(5) screen <i>8</i> , <i>94</i> (length) (depth to top)			
<i>4</i> , <i>Plastic</i> (size) (material)			
(6) pump <i>3/4</i> , <i>15</i> (HP) (yield gpm)			
<i>Electric</i> (type power)			
(7) electric log <i>no</i> (yes or no)			
(organization running log)			
(8) how well bottom plugged <i>wood peg</i>			
DRILLERS REMARKS:			


**CODED**

SEP 7 1972

RD. 08  
COMAL

If well telescopes please sketch and show depths.

GROUND LEVEL

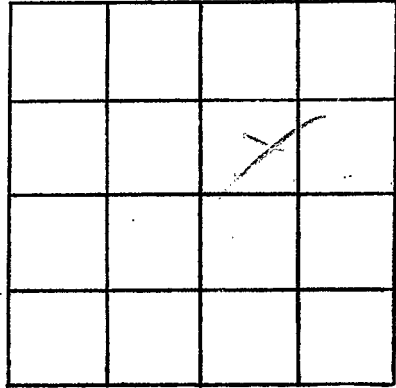

SECTION 6

Please indicate well location X.

ADDITIONAL INFORMATION

If more than one screen,  
show locations of each on sketch.