

Pike  
 D145  
 7-14-72

MISSISSIPPI  
 BOARD OF WATER COMMISSIONERS  
 416 North State Street  
 Jackson, Mississippi 39201

**CODED**

WATER WELL DRILLERS LOG

14 July 1972 date well completed  
 J.T. Carrington firm name  
 Pike county well located

LANDOWNER:  
 Williett Howard  
 Magnolia  
 (mailing address)

description of formations encountered	from	to
Clay	0	15
gyp shale	15	35
shale	35	40
sand shale	40	60
gyp	60	87

WELL LOCATION:  
 sec. 24 T 3 N R 7 E  
 4 miles SW of McComb  
 (distance) (direction) (nearest town)

WELL PURPOSE:  
 (home, irrigation, municipal, industrial)

- WELL COMPLETION DATA:
- (1) diameter (inches) 4
  - (2) total depth (feet) 87
  - (3) static water level (feet) 65 below above top of ground.
  - (4) casing 4" (material), 87 (depth), if telescope see back.
  - (5) screen 6" (length), 87 (depth to top), 4" (size), 4" (material)
  - (6) pump 1/2 (HP), 8 (yield gpm), glet (type power)
  - (7) electric log (yes or no)
  - (organization running log)
  - (8) how well bottom plugged Good

**CODED**


MSB - 5 312

MISS. BD. OF WATER COMM.

DRILLERS REMARKS:

If well telescopes please sketch and show depths.

GROUND LEVEL

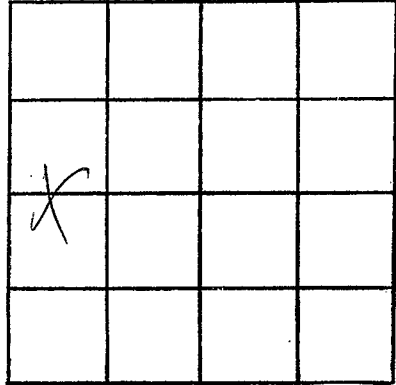

SECTION 34

Please indicate well location X.

ADDITIONAL INFORMATION

Lined area for additional information.

If more than one screen, show locations of each on sketch.