

Pike  
D 146  
9-27-72

MISSISSIPPI  
BOARD OF WATER COMMISSIONERS  
416 North State Street  
Jackson, Mississippi 39201  
WATER WELL DRILLERS LOG

CODED

9-27 1972 Fitzgerald Well Drilling Pike  
date well completed firm name county well located

LANDOWNER:  
James Wells -  
R.R. McComb, Miss.  
(mailing address)

description of formations encountered	from	to
<u>Red Clay</u>	<u>0</u>	<u>20</u>
<u>Red sand</u>	<u>20</u>	<u>70</u>
<u>Coarse sand &amp; gravel</u>	<u>70</u>	<u>85</u>

WELL LOCATION:  
sec. 6 T. 30 S. R. 7 E.  
3 miles W of McComb  
(distance) (direction) (nearest town)

WELL PURPOSE: Home  
(home, irrigation, municipal, industrial)

- WELL COMPLETION DATA:
- (1) diameter (inches) 4
  - (2) total depth (feet) 85
  - (3) static water level (feet) 50 below above top of ground.
  - (4) casing plastic 77,  
(material) (depth)  
4 If telescope see back.  
(size)
  - (5) screen 8, 77  
(length) (depth to top)  
4, plastic  
(size) (material)
  - (6) pump 1/2, 10  
(HP) (yield gpm)  
colt  
(type power)
  - (7) electric log yes  
(yes or no)  
(organization running log)
  - (8) how well bottom plugged wood

CODED


OCT 17 1972

DRILLERS REMARKS:

MISS. WATER

If well telescopes please sketch and show depths.

GROUND LEVEL

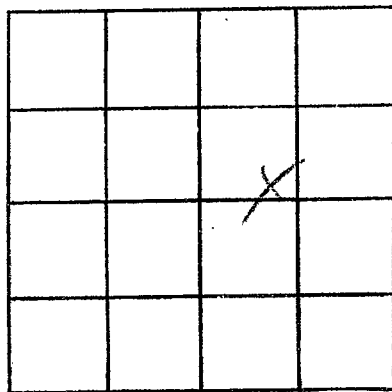

SECTION 6

Please indicate well location X.

ADDITIONAL INFORMATION

If more than one screen,  
show locations of each on sketch.