

Pike  
D147  
10-18-72

MISSISSIPPI  
BOARD OF WATER COMMISSIONERS  
416 North State Street  
Jackson, Mississippi 39201

WATER WELL DRILLERS LOG

**CODED**  
Pelo

10-18  
date well completed

1972 *Fitzmaurice Inc*  
firm name

county well located

LANDOWNER:

*Johnny White*  
*P.R. McComb, owner*  
(mailing address)

description of formations encountered

from

to

<i>Red clay</i>	0	20
<i>Red sand</i>	20	50
<i>Coarse sand &amp; gravel</i>	50	93

WELL LOCATION:

sec. 3 T. 1 N. R. 7 E  
14 W miles McComb of Miss  
(distance) (direction) (nearest town)

WELL PURPOSE:

*Home*  
(home, irrigation, municipal, industrial)

WELL COMPLETION DATA:

- diameter (inches) 4
- total depth (feet) 93
- static water level (feet) 45 below above top of ground.
- casing Plastic 85  
(material) (depth)  
4 if telescope see back.  
(size)
- screen 8 85  
(length) (depth to top)  
4 Plastic  
(size) (material)
- pump 1/2 10  
(HP) (yield gpm)  
elec  
(type power)
- electric log no  
(yes or no)  
(organization running log)
- how well bottom plugged 2 inch pipe

**CODED**


DEC 7 1972

DRILLERS REMARKS:

MISS. Bd. of  
WATER COMMISSIONERS

If well telescopes please sketch and show depths.

GROUND LEVEL

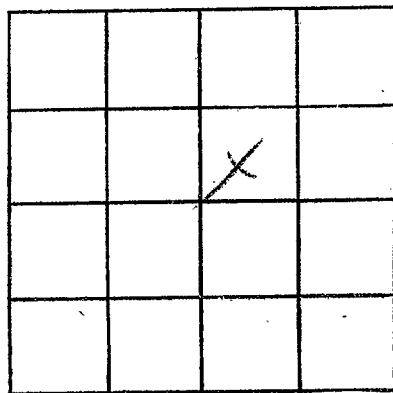

SECTION 3

Please indicate well location X.

ADDITIONAL INFORMATION

If more than one screen,  
show locations of each on sketch.