

Pike
 D 148
 10-3-72

MISSISSIPPI
 BOARD OF WATER COMMISSIONERS
 416 North State Street
 Jackson, Mississippi 39201

CODED

WATER WELL DRILLERS LOG

300x 1977 T. Campstall P. R. K.
 date well completed firm name county well located


| LANDOWNER: | description of formations encountered | from | to |
|---|---------------------------------------|------|----|
| Edw. Shannon Summit (mailing address) | | | |
| | sand dolo | 20 | 30 |
| | sand | 30 | 60 |
| | sand sh | 60 | 96 |
| WELL LOCATION: | | | |
| sec. 9 T. 3 N. R. 7 E. | | | |
| 4 miles W of Summit | | | |
| (distance) (direction) (nearest town) | | | |
| WELL PURPOSE: | | | |
| (home, irrigation, municipal, industrial) | | | |
| WELL COMPLETION DATA: | | | |
| (1) diameter (inches) 4 | | | |
| (2) total depth (feet) 96 | | | |
| (3) static water level (feet) 20 below top of ground. | | | |
| (4) casing (material) PC, (depth) 90 | | | |
| (size) if telescope see back. | | | |
| (5) screen (length) 6, (depth to top) 90 | | | |
| (size) 4, (material) PC | | | |
| (6) pump (HP) 1/2, (yield gpm) 8 | | | |
| (type power) 240v | | | |
| (7) electric log (yes or no) | | | |
| (organization running log) | | | |
| (8) how well bottom plugged wood | | | |
| DRILLERS REMARKS: | | | |

CODED

DEC 26 1972

If well telescopes please sketch and show depths.

GROUND LEVEL

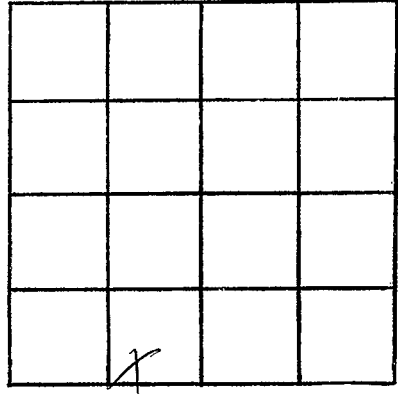

SECTION 9

Please indicate well location X.

ADDITIONAL INFORMATION

If more than one screen,
show locations of each on sketch.