

Pike

D149

12-27-72

MISSISSIPPI  
 BOARD OF WATER COMMISSIONERS  
 416 North State Street  
 Jackson, Mississippi 39201

CODED

WATER WELL DRILLERS LOG

Dec 27 1972  
date well completed

Chester Keenes  
firm name

Pike  
county well located

LANDOWNER: A.R. Sparks  
McComb Miss

description of formations encountered

from

to

clay

0 18

(mailing address)

sand & gravel  
Rea gravel band

18 60  
60 70

WELL LOCATION:

sec. 3 T. 3 N. R. 7 E  
1/2 miles W of McComb  
(distance) (direction) (nearest town)

WELL PURPOSE: Farm  
(home, irrigation, municipal, industrial)

WELL COMPLETION DATA:

- (1) diameter (inches) 4"
- (2) total depth (feet) 70
- (3) static water level (feet) 14 below top of ground.
- (4) casing Plast Bottom  
(material) (depth)
- \_\_\_\_\_ if telescope see back.  
(size)
- (5) screen 6' 64'  
(length) (depth to top)
- 4" Plast  
(size) (material)
- (6) pump 44 15  
(HP) (yield gpm)
- elect  
(type power)
- (7) electric log NO  
(yes or no)

CODED

(organization running log)


(8) how well bottom plugged  
wooden plug

DRILLERS REMARKS:  
New house

DATE 2-6-1973

If well telescopes please  
sketch and show depths.

GROUND LEVEL

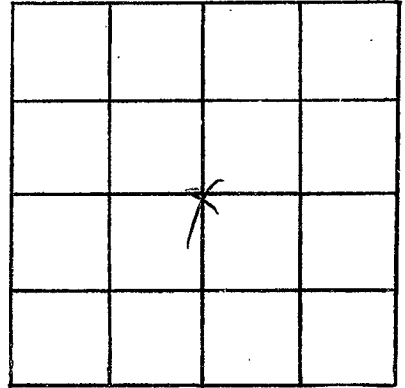

SECTION 3

Please indicate well location X.

ADDITIONAL INFORMATION

If more than one screen,  
show locations of each on sketch.