

Log # 124

150
D 156
PIKE
8-15-73

MISSISSIPPI
BOARD OF WATER COMMISSIONERS
416 North State Street
Jackson, Mississippi 39201

CODED

WATER WELL DRILLERS LOG

8/15 1973 Robert E. Rothiff Co. Inc. Pike
date well completed firm name county well located

LANDOWNER: City of
McComb

(mailing address)

WELL LOCATION:

sec. 1 T. 3 N R. 7 E
S
0 miles 0 of McComb
(distance) (direction) (nearest town)

WELL PURPOSE: Municipal
(home, irrigation, municipal, industrial)

WELL COMPLETION DATA:

- (1) diameter (inches) 16" x 10"
- (2) total depth (feet) 594
- (3) static water level (feet) 192 below top of ground.
- (4) casing Black Tap 502 (material), (depth)
16" if telescope see back.
(size)
- (5) screen 80 454 (length), (depth to top)
10" 555 (size), (material)
- (6) pump 100 1,000 (HP), (yield gpm)
electric (type power)
- (7) electric log yes (yes or no)
Miss. A.S. (organization running log)
- (8) how well bottom plugged Back
Packer Valve

description of formations encountered

from to

Top Soil	0	15
GRAVEL	15	85
Clay	85	117
Shells + fine Sand	117	180
Clay	180	248
Shells	248	369
Harder Sand	369	489
Sand	489	594
Clay	594	600


CODED

DRILLERS REMARKS:

AUG 17 1973

①

If well telescopes please sketch and show depths.

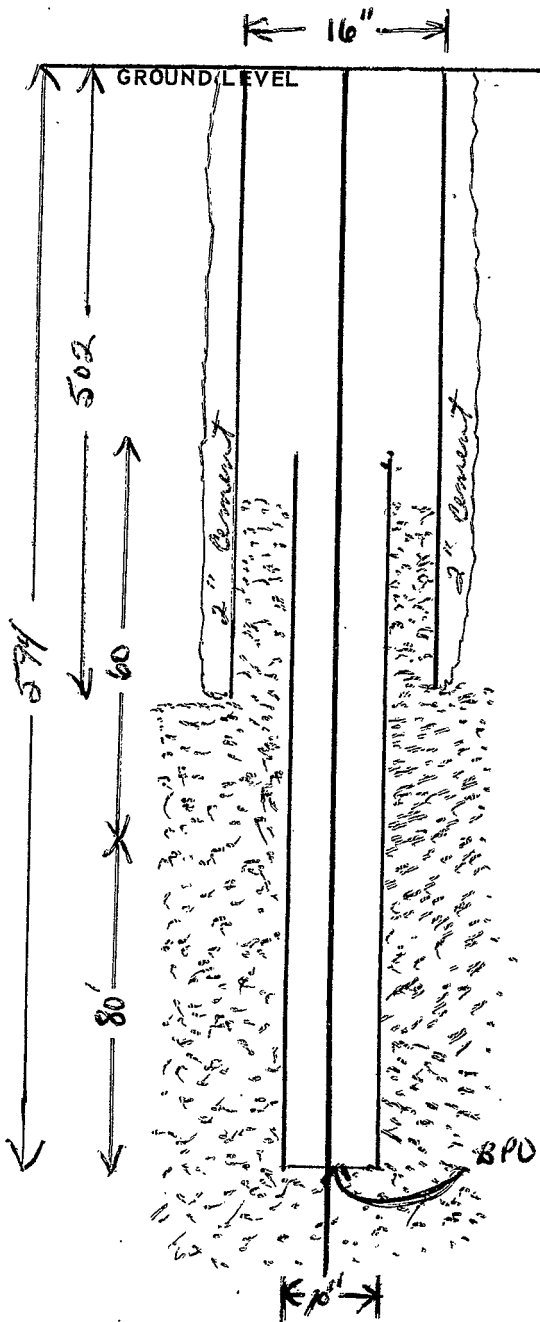

SECTION _____

Please indicate well location X.

ADDITIONAL INFORMATION

If more than one screen, show locations of each on sketch.