

Pike
 D 151
 3-14-73

MISSISSIPPI
 BOARD OF WATER COMMISSIONERS
 416 North State Street
 Jackson, Mississippi 39201

CODED

WATER WELL DRILLERS LOG

14 March 1973 J.T. Carington Son Pike
 date well completed firm name county well located

LANDOWNER:	description of formations encountered	from	to
McComb Diesel McComb Miss (mailing address)			
WELL LOCATION:			
sec. 34 T 9 N R 7 E 2 miles W of Fenwood (distance) (direction) (nearest town)			
WELL PURPOSE: (home, irrigation, municipal, industrial)			
WELL COMPLETION DATA:			
(1) diameter (inches) 4			
(2) total depth (feet) 124			
(3) static water level (feet) 75 below top of ground.			
(4) casing (material) (depth)			
(5) screen (length) (depth to top)			
(6) pump (HP) (yield gpm)			
(7) electric log (yes or no)			
(8) how well bottom plugged wood			
DRILLERS REMARKS:			


description of formations encountered	from	to
Clay	0	20
Chalk sand	20	65
2nd	65	55
Chalk	55	70
sand	70	124

CODED

3 1973

If well telescopes please sketch and show depths.

GROUND LEVEL

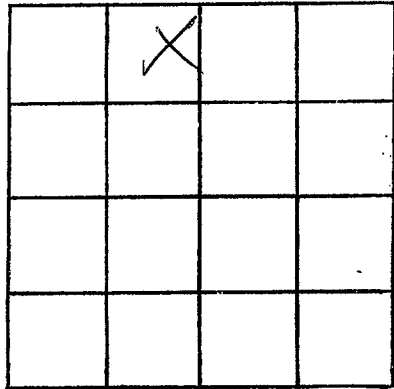

SECTION 34

Please indicate well location X.

ADDITIONAL INFORMATION

If more than one screen,
show locations of each on sketch.