

CODED

MISSISSIPPI
BOARD OF WATER COMMISSIONERS
416 North State Street
Jackson, Mississippi 39201

WATER WELL DRILLERS LOG

D 155
PIKE
7-25-73

7-25
date well completed

19 73 *Flygould well dr*
firm name


Pete
county well located

LANDOWNER:	description of formations encountered	from	to
<i>W.C. Rice</i>			
<i>R.R. McComb</i> (mailing address)	<i>Red clay</i>	<i>2</i>	<i>20</i>
WELL LOCATION:	<i>Red sand</i>	<i>20</i>	<i>65</i>
sec <i>24</i> T <i>30</i> S R <i>7</i> E <i>1</i> miles <i>S</i> of <i>McComb</i> (distance) (direction) (nearest town)	<i>Coarse sand & gravel</i>	<i>65</i>	<i>80</i>
WELL PURPOSE: <i>Home</i> (home, irrigation, municipal, industrial)			
WELL COMPLETION DATA:			
(1) diameter (inches) <i>4</i>			
(2) total depth (feet) <i>80</i>			
(3) static water level (feet) <i>55</i> below above top of ground.			
(4) casing <i>plastic</i> , <i>72</i> , (material) (depth) <i>4</i> (size) if telescope see back.			
(5) screen <i>8</i> , <i>72</i> (length) (depth to top) <i>4</i> , <i>plastic</i> (size) (material)			
(6) pump <i>1/2</i> , <i>6</i> (HP) (yield gpm) <i>elec</i> (type power)			
(7) electric log <i>yes</i> (yes or no) <i>Walpy</i> (organization running log)			
(8) how well bottom plugged <i>Walpy</i>			
DRILLERS REMARKS:			

AUG 15 1973

If well telescopes please sketch and show depths.

GROUND LEVEL

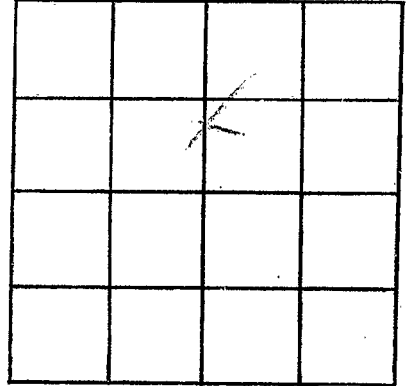

SECTION 24

Please indicate well location X.

ADDITIONAL INFORMATION

If more than one screen, show locations of each on sketch.