

D 156
PIKE
5-14-73

MISSISSIPPI
BOARD OF WATER COMMISSIONERS
416 North State Street
Jackson, Mississippi 39201

CODED

WATER WELL DRILLERS LOG

May 14 1973 Chester Keene Libo
date well completed firm name county well located

LANDOWNER: Outcast Law
McLamb

description of formations encountered	from	to
<u>red sand, clay</u>		
<u>gravel, mixed</u>	<u>0</u>	<u>18</u>
<u>Sand</u>	<u>18</u>	<u>29</u>
<u>Small gravel & Sand</u>	<u>29</u>	<u>55</u>

(mailing address)

WELL LOCATION:

sec. 24 T. 3 N. R. 7 E.
3 1/2 miles SW McLamb
(distance) (direction) (nearest town)

WELL PURPOSE: farm
(home, irrigation, municipal, industrial)

WELL COMPLETION DATA:

- (1) diameter (inches) 4"
- (2) total depth (feet) 55
- (3) static water level (feet) 32 below top of ground.
- (4) casing Plast Ballam
(material) (depth)
- _____ If telescope see back.
(size)
- (5) screen 6' 49'
(length) (depth to top)
- 4" Plast
(size) (material)
- (6) pump By others
(HP) (yield gpm)
- _____ (type power)
- (7) electric log No
(yes or no)
- _____ (organization running log)

CODED


(8) how well bottom plugged wooden plug

DRILLERS REMARKS: old well hole

AUG 20 1973

If well telescopes please sketch and show depths.

GROUND LEVEL

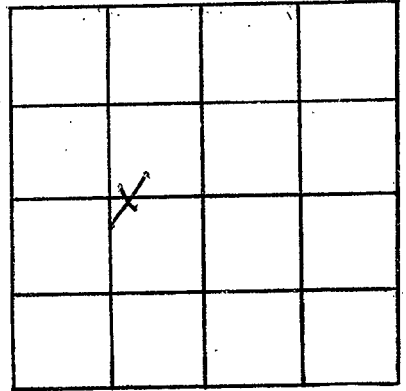

SECTION 21

Please indicate well location X.

ADDITIONAL INFORMATION

If more than one screen, show locations of each on sketch.