

D 157
 PIKE
 6-8-73

MISSISSIPPI
 BOARD OF WATER COMMISSIONERS
 416 North State Street
 Jackson, Mississippi 39201

CODED

WATER WELL DRILLERS LOG

June 8 1973 Chesto Reeves Rebo
 date well completed firm name county well located

LANDOWNER: *B. DeWey*
Liberty
 (mailing address)

WELL LOCATION:
 sec. 27 T. 3 N R. 7 E
2 miles W of Farmwood
 (distance) (direction) (nearest town)

WELL PURPOSE: *Salt Water*
 (home, irrigation, municipal, industrial)

- WELL COMPLETION DATA:
- (1) diameter (inches) 4"
 - (2) total depth (feet) 170
 - (3) static water level (feet) 65 below above top of ground.
 - (4) casing Cast, Bottom
 (material) (depth)
 - _____ If telescope see back.
 (size)
 - (5) screen 10' 110'
 (length) (depth to top)
 - 4" plastic
 (size) (material)
 - (6) pump 1 1/2 30
 (HP) (yield gpm)
 - Steel
 (type power)
 - (7) electric log No
 (yes or no)
 - _____ (organization running log)
 - (8) how well bottom plugged no bottom plug

description of formations encountered	from	to
Red Clay	0	16
Red Sand	16	70
Sand & gravel	70	87
Slightly shaly	87	99
Red gravel & sand	99	170


CODED

DRILLERS REMARKS:
New location

AUG 20 1973

If well telescopes please sketch and show depths.

GROUND LEVEL

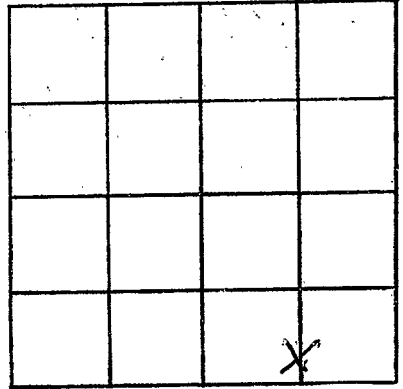

SECTION 27

Please indicate well location X.

ADDITIONAL INFORMATION

If more than one screen, show locations of each on sketch.