

D 158
 PIKE
 6-27-73

MISSISSIPPI
 BOARD OF WATER COMMISSIONERS
 416 North State Street
 Jackson, Mississippi 39201

CODED

WATER WELL DRILLERS LOG

June 27 1973 Chester Bevers Pike
 date well completed firm name county well located

LANDOWNER: Corey Bevers
State Park
McCamb
 (mailing address)

description of formations encountered	from	to
<u>Clay & gravel</u>	<u>0</u>	<u>12</u>
<u>sand & gravel</u>	<u>12</u>	<u>21/2</u>
<u>white chalk</u>	<u>22</u>	<u>55</u>
<u>gravel</u>	<u>55</u>	<u>92</u>

WELL LOCATION:
 sec. 31 T. 3 N. R. 7 E
5 1/2 miles W Fernwood
 (distance) (direction) (nearest town)

WELL PURPOSE: Residential
 (home, irrigation, municipal, industrial)

WELL COMPLETION DATA:

CODED

- (1) diameter (inches) 4"
- (2) total depth (feet) 92
- (3) static water level (feet) 10 below above top of ground.
- (4) casing Plast Bottom
 (material) (depth)

_____ If telescope see back.
 (size)

- (5) screen 10 82
 (length) (depth to top)
- 4" Plast
 (size) (material)
- (6) pump Butcher's
 (HP) (yield gpm)

_____ (type power)

- (7) electric log NO
 (yes or no)

_____ (organization running log)


- (8) how well bottom plugged wooden plug

DRILLERS REMARKS:

AUG 20 1973
 173

If well telescopes please sketch and show depths.

GROUND LEVEL

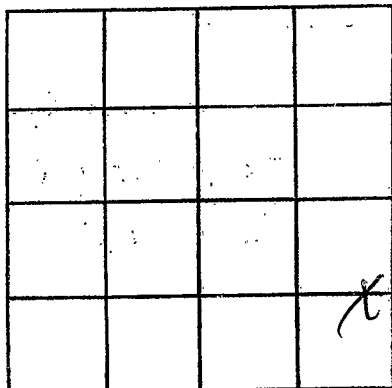

SECTION 31

Please indicate well location X.

ADDITIONAL INFORMATION

If more than one screen, show locations of each on sketch.