

PIKE
D160
10-15-73

MISSISSIPPI
BOARD OF WATER COMMISSIONERS
416 North State Street
Jackson, Mississippi 39201

CODED

WATER WELL DRILLERS LOG

oct 15 1973 chester beever Pike
date well completed firm name county well located

LANDOWNER Andee Martin
Atz, McCamb,

(mailing address)

WELL LOCATION:

sec. 33 T. 3 N. R. 7 E.
4 miles SW of McCamb
(distance) (direction) (nearest town)

WELL PURPOSE:

(home, irrigation, municipal, industrial) Home

WELL COMPLETION DATA:

- (1) diameter (inches) 4"
(2) total depth (feet) 105
(3) static water level (feet) 72 below top of ground
(4) casing Plast Bottom
(material) (depth)

(size) If telescope see back.

- (5) screen 6' 99'
(length) (depth to top)
16" Plast
(size) (material)

- (6) pump 1/2 Sub 15
(HP) (yield gpm)
Electric
(type power)

- (7) electric log No
(yes or no)

(organization running log)

- (8) how well bottom plugged woody plug

DRILLERS REMARKS

New house

description of formations encountered	from to	
<u>Clay</u>	<u>0</u>	<u>17</u>
<u>Red Sand</u>	<u>17</u>	<u>25</u>
<u>Pink Chalk</u>	<u>25</u>	<u>47</u>
<u>Red Sand</u>	<u>47</u>	<u>70</u>
<u>Gravel & Chalk</u>	<u>70</u>	<u>96</u>
<u>Sand & Gravel</u>	<u>96</u>	<u>105</u>


CODED

NOV 7 1973

MISS. Bd. of
WATER COM.

If well telescopes please
sketch and show depths.

GROUND LEVEL

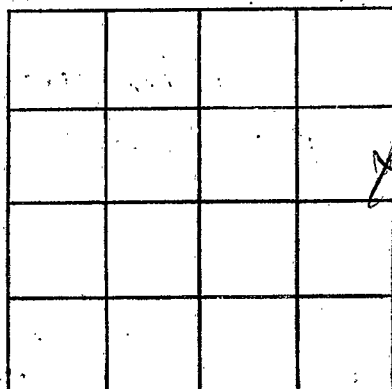

SECTION 32

Please indicate well location X.

ADDITIONAL INFORMATION

If more than one screen,
show locations of each on sketch.