

PIKE  
D161  
10-25-73

MISSISSIPPI  
BOARD OF WATER COMMISSIONERS  
416 North State Street  
Jackson, Mississippi 39201

**CODED**

WATER WELL DRILLERS LOG

10-25 19 23 *F. G. ...* *Blk*  
date well completed firm name county well located

LANDOWNER:

description of formations encountered from to

*Dick Wilson*  
*R.B. ...*  
(mailing address)

*Red clay*  
*fine sand*  
*coarse sand*  
2 22  
30 45  
45 56

WELL LOCATION:

sec 25 3 N R 2 E  
S W  
1 miles S of Mc...  
(distance) (direction) (nearest town)

WELL PURPOSE:  
(home, irrigation, municipal, industrial)

WELL COMPLETION DATA:

- (1) diameter (inches) 4
- (2) total depth (feet) 56
- (3) static water level (feet) 15 below above top of ground.
- (4) casing plst. 48, (material) (depth)  
4 if telescope see back. (size)
- (5) screen 8, 48 (length) (depth to top)  
4, plastic (size) (material)
- (6) pump 1/2 10 (HP) (yield gpm)  
elec (type power)
- (7) electric log Y (yes or no)  
(organization running log)
- (8) how well bottom plugged airly


**CODED**

DRILLERS REMARKS:

NOV 15 1973  
MISS. Bd. of WATER COMMISSIONERS

If well telescopes please sketch and show depths.

GROUND LEVEL

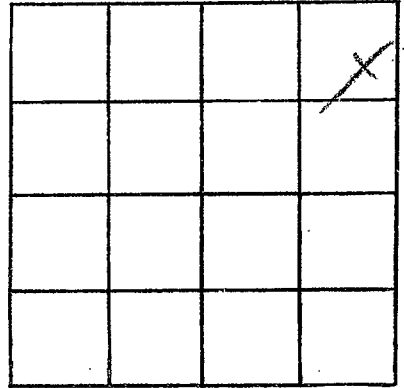

SECTION 5

Please indicate well location X.

ADDITIONAL INFORMATION

If more than one screen, show locations of each on sketch.