

PIKE
D 162
10-13-73

MISSISSIPPI
BOARD OF WATER COMMISSIONERS
416 North State Street
Jackson, Mississippi 39201

WATER WELL DRILLERS LOG

CODED

13 Oct. 1973 *J. T. Brantley* PIKE
date well completed firm name county well located

LANDOWNER: *Beul Downs*
McComb Miss
(mailing address)

description of formations encountered

from	to
0	25
25	60
60	107

WELL LOCATION:
sec. 34 T 3 N R 7 E
3 miles W of Fleming
(distance) (direction) (nearest town)

WELL PURPOSE:
(home, irrigation, municipal, industrial)

- WELL COMPLETION DATA:
- diameter (inches) 4
 - total depth (feet) 107
 - static water level (feet) 75 below top of ground.
 - casing PI 101
(material) (depth)
 if telescope see back.
(size)
 - screen 6 101
(length) (depth to top)
4 PI
(size) (material)
 - pump 1/2 8
(HP) (yield gpm)
glut
(type power)
 - electric log
(yes or no)


(organization running log)
 - how well bottom plugged Wood

DRILLERS REMARKS:

10-13-73

If well telescopes please sketch and show depths.

GROUND LEVEL

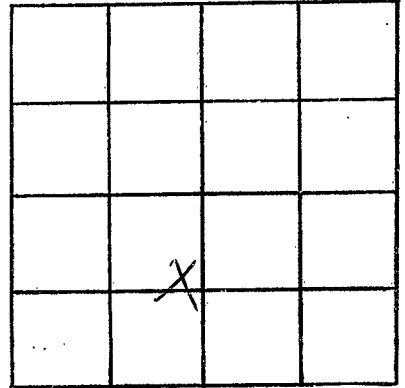

SECTION 34

Please indicate well location X.

ADDITIONAL INFORMATION

If more than one screen, show locations of each on sketch.