

PIKE  
D163  
6-4-74

MISSISSIPPI  
BOARD OF WATER COMMISSIONERS  
416 North State Street  
Jackson, Mississippi 39201

CODED

WATER WELL DRILLERS LOG

6-4 1974 Fitzgerald Well Serv Pike  
date well completed firm name county well located

LANDOWNER:

Raith Sanchez -  
P.O. Box, M'Comb miss.  
(mailing address)

description of formations encountered

from to

<u>Red Clay</u>	<u>0</u>	<u>20</u>
<u>Red Sand</u>	<u>20</u>	<u>80</u>
<u>Coarse sand &amp; gravel</u>	<u>80</u>	<u>100</u>

WELL LOCATION:

sec 28 T 3 N R 7 E  
4 miles W of M'Comb  
(distance) (direction) (nearest town)

WELL PURPOSE: Home  
(home, irrigation, municipal, industrial)

CODED

WELL COMPLETION DATA:

- (1) diameter (inches) 4
- (2) total depth (feet) 100
- (3) static water level (feet) 55 below top of ground.
- (4) casing Plastic, 92,  
(material) (depth)  
4 if telescope see back.  
(size)
- (5) screen 8, 92  
(length) (depth to top)  
4, Plastic  
(size) (material)
- (6) pump 3/4 15  
(HP) (yield gpm)  
Electric  
(type power)
- (7) electric log no  
(yes or no)  
(organization running log)
- (8) how well bottom plugged Standard


RECEIVED

JUL 10 1974

DRILLERS REMARKS:

If well telescopes please sketch and show depths.

GROUND LEVEL

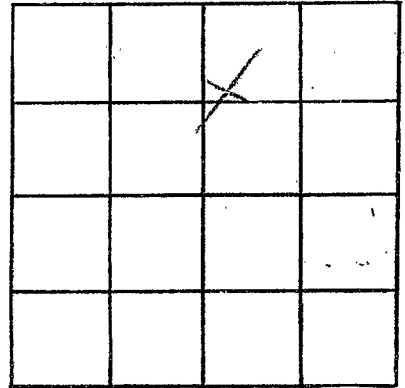

SECTION 28

Please indicate well location X.

ADDITIONAL INFORMATION

If more than one screen,  
show locations of each on sketch.