

PIKE
 D164
 9/2/79

MISSISSIPPI
 BOARD OF WATER COMMISSIONERS
 416 North State Street
 Jackson, Mississippi 39201

WATER WELL DRILLERS LOG

9-2 1974 F. L. Smith Well Service Pike
 date well completed firm name county well located

LANDOWNER:	description of formations encountered	from	to
<u>Dick Wilson</u>			
<u>R.R. McComb</u> (mailing address)	<u>Red Clay</u> <u>White chalk</u> <u>Coarse Sand</u>	<u>0</u> <u>15</u> <u>85</u>	<u>15</u> <u>85</u> <u>97</u>
WELL LOCATION:			
sec. <u>25</u> T. <u>3</u> R. <u>7E</u>			
<u>1</u> miles <u>S</u> of <u>McComb</u> (distance) (direction) (nearest town)			
WELL PURPOSE: <u>Home</u> (home, irrigation, municipal, industrial)			
WELL COMPLETION DATA:			
(1) diameter (inches) <u>4</u>			
(2) total depth (feet) <u>97</u>			
(3) static water level (feet) <u>2</u> <u>below</u> above top of ground.			
(4) casing <u>plastic</u> , <u>89</u> (material) (depth)			
<u>4</u> If telescope see back. (size)			
(5) screen <u>8</u> , <u>89</u> (length) (depth to top)			
<u>4</u> , <u>plastic</u> (size) (material)			
(6) pump <u>1/2</u> , <u>15</u> (HP) (yield gpm)			
<u>electric</u> (type power)			
(7) electric log <u>no</u> (yes or no)			
(organization running log)			
(8) how well bottom plugged <u>Sand blank</u>			
DRILLERS REMARKS:			
OCT 1979			

CODED


DECEMBER

OCT 1979

MISS. B.L.L.

If well telescopes please sketch and show depths.

GROUND LEVEL

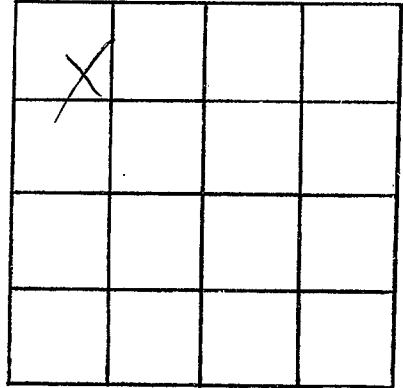

SECTION 25

Please indicate well location X.

ADDITIONAL INFORMATION

If more than one screen,
show locations of each on sketch.