




If well telescopes please sketch and show depths.

GROUND LEVEL

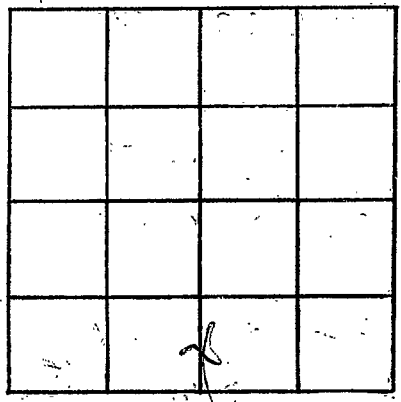

SECTION 37

Please indicate well location X.

ADDITIONAL INFORMATION

A series of horizontal lines for recording additional information, starting below the 'ADDITIONAL INFORMATION' header and extending to the bottom of the page.

If more than one screen, show locations of each on sketch.