

PIKE
D 172
6-26-74

MISSISSIPPI
BOARD OF WATER COMMISSIONERS
416 North State Street
Jackson, Mississippi 39201

CODED

WATER WELL DRILLERS LOG

June 26 1974 Chester Keenes Pike
date well completed firm name county well located

LANDOWNER: Can-Car
Chue
Fernwood Drive
(mailing address)

WELL LOCATION:
sec 17 T 3 N R 7 E
2 miles W Fernwood
(distance) (direction) (nearest town)

WELL PURPOSE: Industrial
(home, irrigation, municipal, industrial)

- WELL COMPLETION DATA:
- (1) diameter (inches) 4"
 - (2) total depth (feet) 100
 - (3) static water level (feet) 62 below above top of ground.
 - (4) casing Plast Ballon
(material) (depth)
 - (size) if telescope see back.
 - (5) screen 6' 94'
(length) (depth to top)
 - 1/2" Plast
(size) (material)
 - (6) pump 3/4 Sub 15
(HP) (yield gpm)
 - Plast
(type power)
 - (7) electric log NO
(yes or no)

(organization running log)

(8) how well bottom plugged wooden plug

DRILLERS REMARKS: no previous well

description of formations encountered	from	to
<u>Red Clay</u>	<u>0</u>	<u>20</u>
<u>Red sand</u>	<u>20</u>	<u>64</u>
<u>big gravel</u>	<u>64</u>	<u>78</u>
<u>loosely sand</u>	<u>78</u>	<u>88</u>
<u>small red gravel & hard</u>	<u>88</u>	<u>100</u>


CODED

RECEIVED
FEB 16 1975

MISS. BD. OF WATER COMMISSIONERS

If well telescopes please sketch and show depths.

GROUND LEVEL

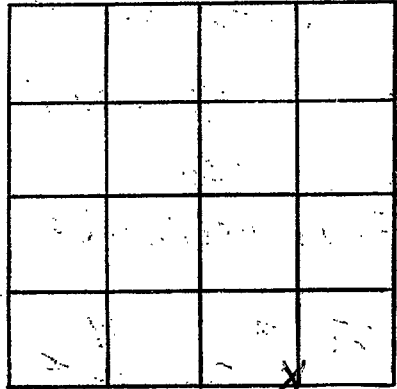

SECTION 27

Please indicate well location X.

ADDITIONAL INFORMATION

If more than one screen, show locations of each on sketch.