

PIKE  
D173  
2-8-75

MISSISSIPPI  
BOARD OF WATER COMMISSIONERS  
416 North State Street  
Jackson, Mississippi 39201

CODED

WATER WELL DRILLERS LOG

Feb-8 1975 Chestnut Creek Pike  
date well completed firm name county well located

LANDOWNER:  
Jeff W. Smith  
Rt 3 Milcomb  
(mailing address)


description of formations encountered	from	to
sand clay	0	12
red sand	12	57
sand & gravel	57	61
pebbles	61	89
fragments sand	89	98

WELL LOCATION:  
sec 26 T 3 N R 7 E  
3 miles W.S.W. of Milcomb  
(distance) (direction) (nearest town)

WELL PURPOSE: home  
(home, irrigation, municipal, industrial)

- WELL COMPLETION DATA:
- (1) diameter (inches) 4"
  - (2) total depth (feet)
  - (3) static water level (feet) 32 below top of ground
  - (4) casing plastic bottom  
(material) (depth)
  - (size) if telescope see back.
  - (5) screen 6 92  
(length) (depth to top)
  - 4" plastic  
(size) (material)
  - (6) pump 1/2 HP 10  
(type power) (yield gpm)
  - elect  
(type power)
  - (7) electric log no  
(yes or no)
  - (organization running log)
  - (8) how well bottom plugged water plug

CODED

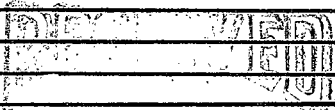

FEB 21 1975

DRILLERS REMARKS:  
pile well fitted  
with good

