

D 176  
 Pike  
 5/22/75

MISSISSIPPI  
 BOARD OF WATER COMMISSIONERS  
 416 North State Street  
 Jackson, Mississippi 39201

CODED

WATER WELL DRILLERS LOG

5-22 1975 *F. Fitzgerald* *Pike*  
 date well completed firm name county well located


LANDOWNER:	description of formations encountered	from	to
<i>Steve Walsh</i>			
<i>R.B. McComb</i> (mailing address)	<i>Red Clay</i>	<i>0</i>	<i>20</i>
	<i>Red Soil</i>	<i>20</i>	<i>90</i>
	<i>Coarse sand &amp; gravel</i>	<i>90</i>	<i>110</i>
WELL LOCATION: sec. <i>28</i> T. <i>3</i> N R. <i>7</i> E <i>4</i> miles <i>W</i> of <i>McComb</i> (distance) (direction) (nearest town)			
WELL PURPOSE: (home, irrigation, municipal, industrial)			
WELL COMPLETION DATA:			
(1) diameter (inches) <i>4</i>			
(2) total depth (feet) <i>110</i>			
(3) static water level (feet) <i>75</i> below above top of ground.			
(4) casing <i>plastic</i> , <i>102</i> , (material) (depth) <i>4</i> (size) If telescope see back.			
(5) screen <i>8</i> , <i>102</i> (length) (depth to top)			
<i>4</i> , <i>plastic</i> (size) (material)			
(6) pump <i>1</i> , <i>20</i> (HP) (yield gpm)			
<i>elec</i> (type power)			
(7) electric log <i>no</i> (yes or no)			
(organization running log)			
(8) how well bottom plugged <i>sealed</i>			
DRILLERS REMARKS:			

REGISTERED  
 JUN 10 1975

MISS. BD. OF WATER COMMISSIONERS

If well telescopes please sketch and show depths.

GROUND LEVEL

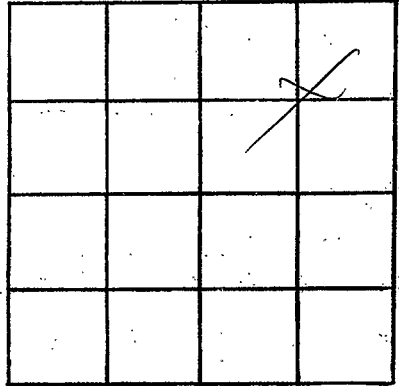

SECTION 28

Please indicate well location X.

ADDITIONAL INFORMATION

If more than one screen, show locations of each on sketch.