

Pipe
 D 178
 4-26-75

MISSISSIPPI
 BOARD OF WATER COMMISSIONERS
 416 North State Street
 Jackson, Mississippi 39201

CODED

WATER WELL DRILLERS LOG

April 26 1975 Chaste Pump Pipe
 date well completed firm name county well located

LANDOWNER:	description of formations encountered	from	to
<u>Mr. Carry Andrews</u>			
<u>Attn. McCombe</u> (mailing address)	<u>Red sand</u>	<u>20</u>	<u>80</u>
	<u>Mixed sand & chalk</u>	<u>80</u>	<u>100</u>
	<u>Small gravel</u>	<u>100</u>	<u>108</u>

WELL LOCATION:
 sec. 28 T 3 N R. 7 E ^{14H}
3 1/2 miles W-SW of McCombe
 (distance) (direction) (nearest town)

WELL PURPOSE: Home
 (home, irrigation, municipal, industrial)


- WELL COMPLETION DATA:
- (1) diameter (inches) 4"
 - (2) total depth (feet) 108
 - (3) static water level (feet) 65 below top of ground.
 - (4) casing plaster bottom
 (material) (depth)
 - If telescope see back.
 (size)
 - (5) screen 6' 102
 (length) (depth to top)
 - 1/2" plastic
 (size) (material)
 - (6) pump 1/2 sub 10
 (HP) (yield gpm)
 - elect
 (type power)
 - (7) electric log no
 (yes or no)
 - (organization running log)
 - (8) how well bottom plugged home

DRILLERS REMARKS:
new house

RECEIVED
 MISSISSIPPI
 JUN 30 1975

If well telescopes please sketch and show depths.

GROUND LEVEL

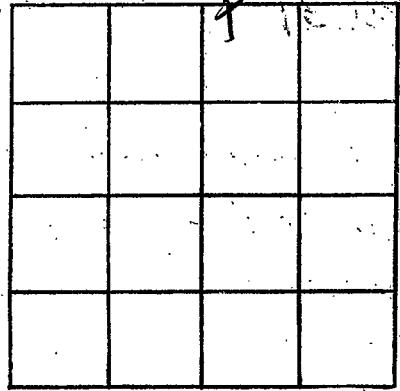

SECTION 28

Please indicate well location X.

ADDITIONAL INFORMATION

If more than one screen, show locations of each on sketch.