

Pike
 D 180
 10-15-75

MISSISSIPPI
 BOARD OF WATER COMMISSIONERS
 416 North State Street
 Jackson, Mississippi 39201

CODED

WATER WELL DRILLERS LOG

10-15 date well completed 1975 firm name Pike county well located

LANDOWNER:
 Tommy Wells
 R.H. McComb
 (mailing address)

description of formations encountered	from	to
Red Clay	0	20
Red sand	20	90
Coarse sand & gravel	90	115

WELL LOCATION:
 sec. 28 T 3 N R 7 E
 4 miles SW of McComb
 (distance) (direction) (nearest town)

WELL PURPOSE:
 (home, irrigation, municipal, industrial)

- WELL COMPLETION DATA:
- (1) diameter (inches) 4
 - (2) total depth (feet) 115
 - (3) static water level (feet) 20 below top of ground.
 - (4) casing PVC, 107' (material) (depth)
 4" (size) If telescope see back.
 - (5) screen 8' 107' (length) (depth to top)
 4" (size) PVC (material)
 - (6) pump 3/4 HP 16 (yield gpm)
 Elec (type power)
 - (7) electric log No (yes or no)
 (organization running log)
 - (8) how well bottom plugged Sand block

DRILLERS REMARKS:


CODED

OCT 16 1975

MISS. Bd. OF WATER COMMISSIONERS

If well telescopes please sketch and show depths.

GROUND LEVEL

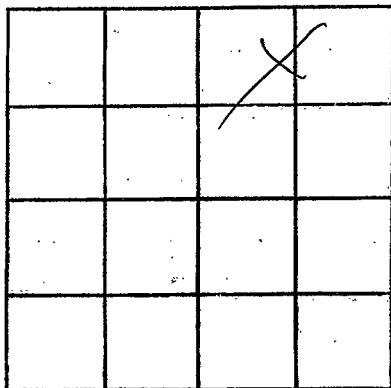

SECTION 28

Please indicate well location X.

ADDITIONAL INFORMATION

If more than one screen, show locations of each on sketch.