

Pike
D 181
9-25-75

MISSISSIPPI
BOARD OF WATER COMMISSIONERS
416 North State Street
Jackson, Mississippi 39201

CODED

WATER WELL DRILLERS LOG

9-25 19 75 Fitzgerald Well Serv. Pike
date well completed firm name county well located

LANDOWNER:	description of formations encountered	from	to
Waldo Cockburn			
R.R. McComb (mailing address)	Red clay	0	20
	Red gravel	20	80
	Coarse sand & gravel	80	100
WELL LOCATION:			
sec. 29 T. 3 (N) S. R. 20 E W			
6 miles W of McComb (distance) (direction) (nearest town)			
WELL PURPOSE: Home (home, irrigation, municipal, industrial)			
WELL COMPLETION DATA:			
(1) diameter (inches) 4			
(2) total depth (feet) 100			
(3) static water level (feet) 45 below top of ground			
(4) casing plastic, 92 (material) (depth)			
4 (size) If telescope see back.			
(5) screen 8, 92 (length) (depth to top)			
4 plastic (size) (material)			
(6) pump 3/4, 16 (HP) (yield gpm)			
Electric (type power)			
(7) electric log no (yes or no)			
(organization running log)			
(8) how well bottom plugged Sand shell			

CODED


DECEMBER 18 1975

NOV 18 1975

DRILLERS REMARKS:

If well telescopes please sketch and show depths.

GROUND LEVEL

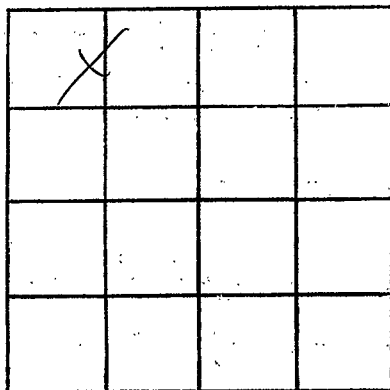

SECTION 29

Please indicate well location X.

ADDITIONAL INFORMATION

If more than one screen, show locations of each on sketch.