

PIKE
 D 182
 3/15/78
 F Log # 137

MISSISSIPPI
 BOARD OF WATER COMMISSIONERS
 416 North State Street
 Jackson, Mississippi 39201

WATER WELL DRILLERS LOG

CODED

3-15-1978 SPRINGER DRILLING SERVICE PIKE
 date well completed firm name county well located

LANDOWNER: SUNNY HILL
 WATER ASSN. T. H. #1
 For well # 2
 (mailing address)

WELL LOCATION: SW 1/4 SW 1/4 SW 1/4 SW 1/4
 sec 27 T 3 N R 7 E W
 miles of (distance) (direction) (nearest town)

WELL PURPOSE:
 (home, irrigation, municipal, industrial)

- WELL COMPLETION DATA:
- (1) diameter (inches) _____
 - (2) total depth (feet) _____
 - (3) static water level (feet) _____ below/above top of ground
 - (4) casing (material) (depth) _____ (size) if telescope see back.
 - (5) screen (length) (depth to top) _____ (size) (material)
 - (6) pump (HP) (yield gpm) _____
 Elect. (type power)
 - (7) electric log YES (yes or no)
 MGS (organization running log)
 - (8) how well bottom plugged BACK
 WASH UNPLUG


description of formations encountered	from	to
TOP SOIL	0	4
Red SANDY CLAY + SAND	4	82
CLAY	82	98
SAND + GRAVEL	98	128
CLAY	128	222
SAND	222	306
CLAY (HARD)	306	654
SAND streaks w/ clay	654	762
CLAY	762	818
SAND	818	832
CLAY w/ rocks	832	992
SAND	992	1004
CLAY w/ rocks	1004	1075

RECEIVED
 MAR 20 1978
 MISS. BD. OF WATER COMMISSIONERS

DRILLERS REMARKS:

If well telescopes please sketch and show depths.

GROUND LEVEL

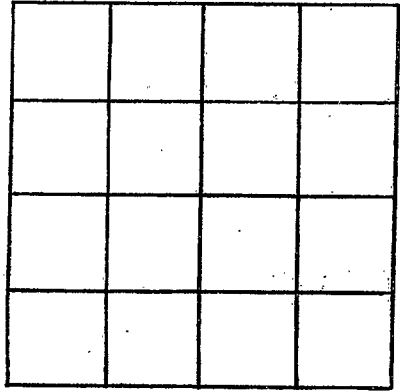

SECTION _____

Please indicate well location X.

ADDITIONAL INFORMATION

If more than one screen, show locations of each on sketch.