

# MISSISSIPPI DEPARTMENT OF ENVIRONMENTAL QUALITY

Office of Land and Water Resources

P. O. Box 10631

Jackson, MS 39289-0631

### WATER WELL DRILLERS LOG

COUNTY WELL LOCATED  
Pike

WELL NUMBER <u>D-203</u>	CODED
DATE WELL COMPLETED <u>9-20-00</u>	

PERMIT NUMBER <u>079</u>
NAME OF DRILLING FIRM <u>Reeves Well Ser.</u>

NAME & MAILING ADDRESS OF LANDOWNER #382 <u>McComb City Lodge</u>			
<u>Old Liberty Rd.</u>			
<u>McComb Miss.</u>			
Latitude:			
Longitude:			
WELL LOCATION	SEC <u>23</u>	TOWNSHIP <u>3</u>	RANGE <u>7</u> <sup>W</sup>
DISTANCE <u>12</u>	DIRECTION <u>W</u>	NEAREST TOWN of <u>McComb</u>	
OTHER LANDMARK			
WELL PURPOSE: Home, Irrigation, Municipal, Industrial, Fish Pond, etc.			

PUMP DATA		
PUMP TYPE (Circle One):		
<input type="checkbox"/> Submersible,	<input type="checkbox"/> Turbine,	<input type="checkbox"/> Jet <input type="checkbox"/> Flowing Well,
Other (Describe) _____		
POWER TYPE (Circle One):		
<input type="checkbox"/> Electric,	<input type="checkbox"/> Tractor,	<input type="checkbox"/> Diesel, <input type="checkbox"/> Gasoline, <input type="checkbox"/> Butane,
Other (Describe) _____ H/P <u>12</u>		
DESCRIPTION OF FORMATIONS ENCOUNTERED	FROM	TO
<u>Clay</u>	<u>0</u>	<u>30</u>
<u>Sand &amp; gravel</u>	<u>30</u>	<u>70</u>
<u>lumpy sand</u>	<u>70</u>	<u>100</u>
<u>sand, Pea gravel</u>	<u>100</u>	<u>110</u>
RECEIVED		
FEB 27 2001		
BY: OLWR		
Top of Lap Pipe or Reduction in Casing		
FEET	IF TELESCOPED OR MORE THAN ONE SCREEN: USE BACK PAGE	

### WELL DATA

Well Depth <u>117'</u>	Casing Diameter (In.) <u>4"</u>	Casing Length (Ft.) <u>20'</u>
Type of Casing <u>PVC</u>	Hole Depth <u>117</u>	Depth to Static Water Level <u>70'</u>
TYPE OF COMPLETION: (Circle One or More):		
<input type="checkbox"/> Gravel Packed, <input type="checkbox"/> Underreamed, <input type="checkbox"/> Telescoped,		
<input type="checkbox"/> Natural Development, <input type="checkbox"/> Open Hole, <input type="checkbox"/> Other		
(Describe) <u>10 Gal. sand</u>		
WELL GROUTED TO A DEPTH OF <u>10'</u> FEET		
Type Grout (circle one): <u>Cement</u> , Bentonite, or Mix		

### SCREEN DATA

Diameter - Inches <u>4"</u>	Length - Feet <u>10'</u>	Slot Size - Inches <u>10ths.</u>
Screen Type <u>PVC</u>	Depth to Bottom - Feet <u>117'</u>	

I certify that the well was drilled, constructed and completed in accordance with all applicable Requirements of the Mississippi Department of Environmental Quality and/or the Mississippi Department of Health regulations and state laws.


Jimmy Reeves 0-668  
Signature of Licensed Driller and License No.

9-20-00  
Date

Additional Information Required On Back

If well telescopes please sketch and show depths.

GROUND LEVEL

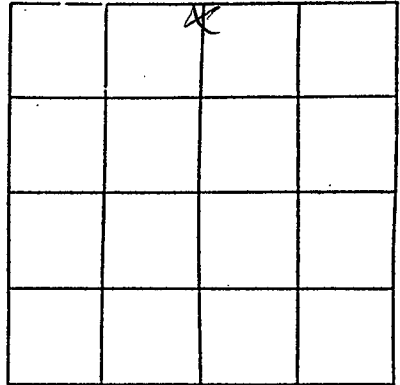

SECTION 23

Please indicate well location X.

Pump Capacity (GPM)	No. of Stages	Setting Depth
<u>10</u>	<u>8</u>	<u>100</u> FT.

PUMP TEST

Well yielded 50 GPM with  
a drawdown of 0 ft.  
after 1 hours of pumping

LOG DATA

TYPE OF LOG RUN (Circle One):  No Log Run,  
 Electric,  Gamma Ray,  Density,  Sonic,  Neutron,  
Other (Describe) \_\_\_\_\_

Name of Organization Running Log \_\_\_\_\_

GEOLOGIC DATA (Office Use Only)

Surface Elev.	Geologic Unit	Unit Thickness	Depth to Top
Subs. SWL	Date	Analysis	Aquifer Test

Driller's Remarks

\_\_\_\_\_  
\_\_\_\_\_  
If more than one screen,  
show location of each on sketch.