

MISSISSIPPI DEPARTMENT OF ENVIRONMENTAL QUALITY

Office of Land and Water Resources

P. O. Box 10631
Jackson, MS 39289-0631
WATER WELL DRILLERS LOG

COUNTY WELL LOCATED <u>Pike</u>	
WELL NUMBER D-210	CODED
DATE WELL COMPLETED <u>10/31/03</u>	

PERMIT NUMBER
NAME OF DRILLING FIRM <u>Green Water Well & Sunny</u> <u>1318 Priceville Dr. SE</u> <u>Bohannon, MS 39029</u>

NAME & MAILING ADDRESS OF LANDOWNER <u>Bret Lampton</u> <u>PO Box 740, Magnolia, MS</u>			
Latitude:			
Longitude:			
WELL LOCATION	SEC <u>25</u>	TOWNSHIP <u>3</u> ^N _S	RANGE <u>7</u> ^E _W
DISTANCE <u>0</u> Miles	DIRECTION	NEAREST TOWN <u>Farmwood</u>	
OTHER LANDMARK			
WELL PURPOSE: Home <u>Irrigation</u> Municipal, Industrial, Fish Pond, etc.			

PUMP DATA	
PUMP TYPE (Circle One): <u>Submersible</u> Turbine, Jet, Flowing Well, Other (Describe) _____	
POWER TYPE (Circle One): <u>Electric</u> Tractor, Diesel, Gasoline, Butane, Other (Describe) _____ <u>H/P 3</u>	

DESCRIPTION OF FORMATIONS ENCOUNTERED	FROM	TO
<u>red clay</u>	<u>0</u>	<u>17</u>
<u>red sand</u>	<u>17</u>	<u>44</u>
<u>white clay</u>	<u>44</u>	<u>57</u>
<u>gravel</u>	<u>57</u>	<u>77</u>
<u>sand & gravel</u>	<u>77</u>	<u>125</u>
<u>sand w/ clay streaks</u>	<u>125</u>	<u>130</u>
<u>white clay</u>	<u>130</u>	<u>135</u>

WELL DATA		
Well Depth <u>130</u>	Casing Diameter (In.) <u>4</u>	Casing Length (Ft.) <u>100</u>
Type of Casing <u>PVC</u>	Hole Depth <u>135</u>	Depth to Static Water Level <u>52</u>
TYPE OF COMPLETION: (Circle One or More): <u>Gravel Packed</u> Underreamed, Telescoped, Natural Development, Open Hole, Other (Describe) _____		
WELL GROUTED TO A DEPTH OF <u>10 FEET</u> Type Grout (circle one): Cement, Bentonite, <u>Mix</u>		

SCREEN DATA		
Diameter - Inches <u>4</u>	Length - Feet <u>30</u>	Slot Size - Inches <u>.010</u>
Screen Type <u>PVC</u>	Depth to Bottom - Feet <u>130</u>	

RECEIVED	
NOV 10 2003	
BY: OLWR	
Top of Lap Pipe or Reduction in Casing	
FEET	IF TELESCOPED OR MORE THAN ONE SCREEN: USE BACK PAGE

I certify that the well was drilled, constructed and completed in accordance with all applicable Requirements of the Mississippi Department of Environmental Quality and/or the Mississippi Department of Health regulations and state laws.


Brian McClellan 664
Signature of Licensed Driller and License No.

10/31/03
Date

Additional Information Required On Back

If well telescopes please sketch and show depths.

GROUND LEVEL

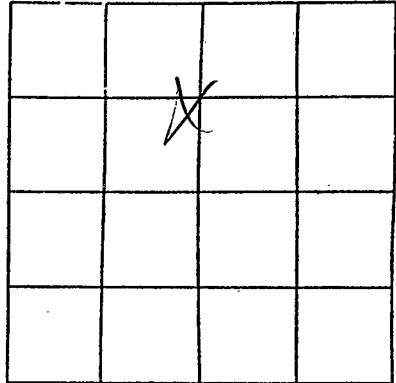

SECTION 25

Please indicate well location X.

Pump Capacity (GPM)	No. of Stages	Setting Depth
<u>25</u>	<u>15</u>	<u>95</u> FT.

PUMP TEST

Well yielded 35 GPM with
 a drawdown of 4 ft.
 after 2 hours of pumping

LOG DATA

TYPE OF LOG RUN (Circle One): No Log Run
 Electric, Gamma Ray, Density, Sonic, Neutron,
 Other (Describe) _____

Name of Organization Running Log _____

GEOLOGIC DATA (Office Use Only)

Surface Elev.	Geologic Unit	Unit Thickness	Depth to Top
Subs. SWL	Date	Analysis	Aquifer Test

Driller's Remarks

If more than one screen,
 show location of each on sketch.