

Re Submit

RECEIVED

MAR 01 2013

BY: OLWR

County: Pike  
 Permit #: \_\_\_\_\_  
 Driller: Pittzgerald Well Service  
 Date drilling completed: 12-31-12

State Well Report  
 Part 1 - Driller's Log  
 Mississippi Department of Environmental Quality  
 Office of Land and Water Resources  
 P.O. Box 2309  
 Jackson, MS 39225  
 (601)961-5210  
 (601)961-5228 (fax)

For Office Use Only:  
 Aquifer: \_\_\_\_\_  
 Well #: D280  
 L. S. Elevation: \_\_\_\_\_  
 E-log #: \_\_\_\_\_

State Law requires that this report be prepared by the license holder responsible for the work and filed with the Department at the above address within 30 days of completion of drilling of the well or borehole.

| Information on Well Owner<br>(Landowner if borehole is not for a water well) | Well or Borehole Location   |
|--|---|
| Owner Name: <u>Dr. Carl Feind</u>  | Latitude: <u>31° 12' 44.2"</u> Longitude: <u>90° 29' 57.4"</u>                                      |
| Mailing Address: <u>old liberty Rd.</u>                                      | Method of Lat/Long (circle one): Conventional Survey,<br>USGS quad, Hand-held GPS, Survey-grade GPS |
| <u>M'Comb.</u> MS<br>City State Zip Code                                     | <u>SE</u> 1/4 <u>NE</u> 1/4 Sec <u>21</u> Twn <u>3N</u> Rng <u>2E</u>                               |
| Telephone No. ( ) _____  | Distance _____ Miles Direction <u>West</u> of Nearest Town <u>M'Comb</u>                            |

Well / Borehole Data

Date drilling started: 12-31-12 Date drilling completed: 12-31-12 Hole depth: 113' Hole diameter: 8"

Location of the source of any surface water used for drilling: \_\_\_\_\_  
 Method of dosing and volume of Chlorine used in drilling and development: \_\_\_\_\_

Logs run (circle all applicable): No log run Electric Gamma Ray Density Sonic Neutron Other: \_\_\_\_\_  
 Name of organization running log(s): \_\_\_\_\_

Purpose of borehole (check one): Water Well  Geotechnical/Geological Investigation \_\_\_\_\_ Ground Source Heat Pump \_\_\_\_\_  
 Seismic Survey \_\_\_\_\_ Other (describe) \_\_\_\_\_

*If drilling is not related to water well construction, skip the remainder of this block*

Purpose of Well (check one): Home  Industrial \_\_\_\_\_ Public Supply \_\_\_\_\_ Irrigation  Fish Culture \_\_\_\_\_ Other: Garden

If a flowing well, method of flow regulation: Valve \_\_\_\_\_ Other (describe) \_\_\_\_\_

Static Water Level: 70' feet above or below (circle one) land surface Date measured: 12-31-12

Method of Measurement (circle one) steel tape electric tape air line other: \_\_\_\_\_

Well depth: 113' Well grouted to a depth of 10' feet Type of grout (circle one): Neat Cement Bentonite Mix

Casing length: 93' feet Casing diameter: 4" inches Type of casing: Pvc

Screen length: 20' feet Screen diameter: 4" inches Type of screen: Pvc

Screen slot size: 0.10/0.12 inches Setting depth: From 93' feet to 113' feet

Type of completion (circle all applicable): Gravel packed Underreamed Telescoped Open hole Natural Development  
 Other (describe): \_\_\_\_\_

Top of lap pipe or reduction in casing: \_\_\_\_\_ feet. *If telescoped or more than one screen, describe on next page*

pump set By The Warehouse.

RECEIVED


MAR 01 2013


BY: OLWR

The sketch below only required for water wells

Description of formations encountered must be provided for all wells and boreholes, unless specifically exempted by regulations

If well telescopes, show depths on sketch.


Ground Level 

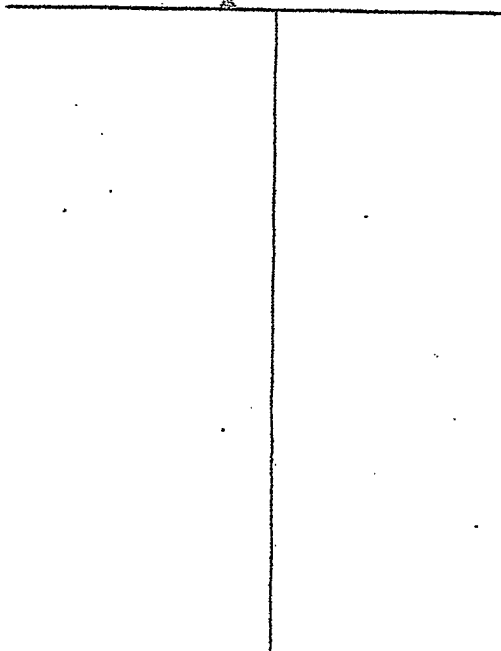

| Description of Formations Encountered | From (depth) | To (depth) |
|---------------------------------------|--------------|------------|
|                                       | Ground Level |            |
| Clay                                  | 0            | 20         |
| Gravel                                | 20           | 40         |
| Sand                                  | 40           | 60         |
| Coarse Sand                           | 60           | 80         |
| White Sand & Gravel                   | 80           | 94         |
|                                       |              |            |
|                                       |              |            |
If more than one screen, show location of each on sketch

Sketch the property layout and include the following: 1) the well location; 2) any permanent structures on the property that may aid in locating the well; 3) any roads, power lines, or other items that may aid in locating the property and the well; 4) a north arrow.

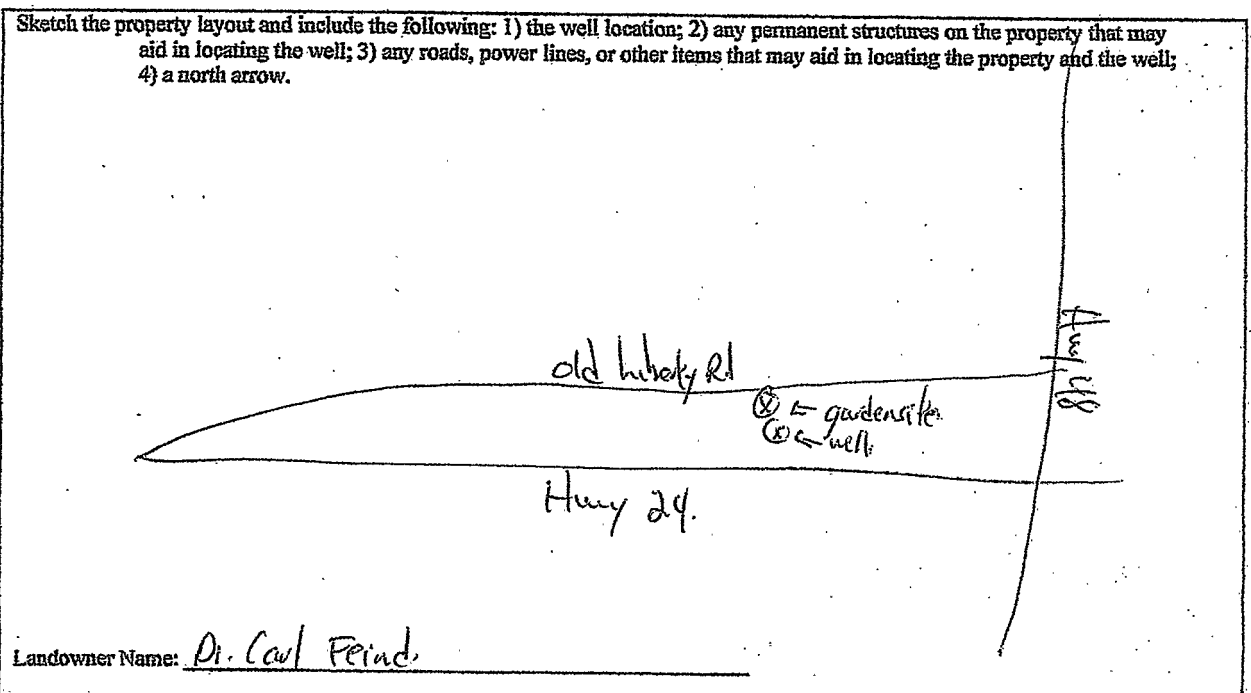

Landowner Name: Di. Carl Feind.

Form: OLWR-SWR-1A (04/08)

I certify that the well/borehole was drilled, constructed, and completed in accordance with all applicable requirements of the Mississippi Department of Environmental Quality and the Mississippi Department of Health regulations, if applicable, and state laws.

Carl Feind      029      12-31-12      Carl Feind

Print Name of Responsible Licensee and License No.      Date      Signature of Licensee