State W	/ell Report	
County: Pike Part 1-1 Mississippi Departme	Driller's Log For Office Use Only:	
mississiphi Departitie	nt of Environmental Quality Aquifer:	
	nd Water Resources Box 2309 Well #: D282	
1 mm 1 - 1 - 1 - 1 - 1 - 1 - 1 - 1 - 1 -	MS 39225	
Date drilling completed: $5 \cdot 2^2 - 12$ (601)	961- 5210 L. S. Elevation:	
(601)96	1- 5228 (fax) E-log #:	
State Law requires that this report be prepared by the license holder responsible for the work and filed with the		
Department at the above address within 30 days of completion of drilling of the well or borehole.		
Information on Well Owner	Well or Borehole Location	
(Landowner if borehole is not for a water well)	Latitude: 30° 15', 40.1" Longitude: 91° 32', 36"	
Owner Name Grand Nagin Mailing Address: Bradley LN.	Method of Lat/Long (circle one): Conventional Survey,	
Maining Address: Drace reg the r	USGS quad, Hand-held GPS, Survey-grade GPS	
Summet MC	NE 1/ NW1/2 Sec_31 Twn 3N Rng7E	
<u>Summit</u> MV. City State Zip Code	Distance Direction Nearest Town Miles of	
Telephone No. ()	Miles of	
Well / Borebole Data		
Date drilling started: $5-23-13$ . Date drilling completed: $5-23-13$ . Hole depth: $197^{-1}$ Hole diameter: $5''$		
Location of the source of any surface water used for drilling;		
Method of dosing and volume of Chlorine used in drilling and devel	opment:	
Logs run (circle all applicable): No log ran, Electric Gamma Ray Density Sonic Neutron Other:		
Purpose of borehole (check one): Water WellGeotechnical/Geological Investigation Ground Source Heat Pump		
Seismic SurveyOther (describe	)	
If drilling is not related to water well construction, skip the remainder of this block		
Purpose of Well (check one): HomeIndustrial Public Supply Irrigation Fish Culture Other:		
If a flowing well, method of flow regulation: Valve Other (describe)		
Static Water Level:		
Method of Measurement (circle one) telectric tape air line other:		
Well depth: 187' Well grouted to a depth of 10 feet Type of grout (circle one): Neat Cement Bentonite Mix		
Casing length: $177^{-1}$ feet Casing diameter: $4^{\prime\prime}$ inches Type of casing: $P_{\nu}c$		
Screen length:		
Screen slot size: inches Setting depth: From feet to		
Type of completion (circle all applicable): Oravel packed Underreamed Telescoped Open hole Natural Development		
Other (describe):		
Top of lap pipe or reduction in casing: feet. If telescoped or more than one screen, describe on next page		
Form: OLWR-SWR-1A (04/08)		

\* 2 .


**\***:#

## The sketch below only required for water wells

If well telescopes, show depths on sketch. Ground Level Description of formations encountered must be provided for all wells and boreholes, unless specifically exempted by regulations

Description of Formations Encountered	From (depth)	To (depth)
	Ground Level	
Cliv	0	20
SanA.	20	40
Clark.	40	60
Sund.	60	101
Chury	100	130
Sand!	130	170
Curite Sana	170	187
		_

If more than one screen, show location of each on sketch

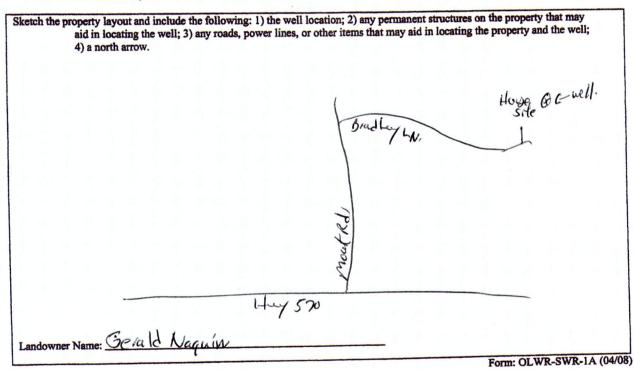

I certify that the well/borehole was drilled, constructed, and completed in accordance with all applicable requirements of the Mississippi Department of Environmental Quality and the Mississippi Department of Health regulations, if applicable, and state

Date

laws 5-23-13-024

Print Name of Responsible Licensee and License No.

Signature of Licensee

RECEIVED JUN 2 1 2013 BY: OLWR

STATE W	ELL REPORT	
County: <u>Pike</u>	For Office Use Only:	
Pump Installer	r's Completion Report Aquifer.	
	and Water Resources	
Driller: <u>Fitzge ald Well</u> fer of P.O.	1 and Water Resources Well #: $D 28 2$	
Date completed: 5-23-13. Jackson	on, MS 39225 Elevation:	
(60	1)961-5210	
<u>Corv information from block on Part 1</u> (601)9	61-5228 (fax)	
This part of the report must be completed by a licensed water well contractor or a licensed pump installer. A copy of Part 1 of the		
report must be attached and both parts filed with the Department Well Owner Information		
Owner Name: Gerald Naquin' Mailing Address: Bradky LN.	Latitude: 31° 15 40.1 Longitude: 90°32 36"	
Mailing Address: Branky LN-	Method of Lat/Long (check one): Conventional Survey,	
	USGS quad, Hand-held GPS, Survey-grade GPS	
Summer + Mal	1414 Sec_37T_3N_R_7E	
<u>Summit Mf</u> City State Zip Code		
	Distance Direction & Nearest Town	
Telephone No. ()	Miles of	
Pump Type	Power Type	
Circle one Air Lift Jet Submersible	Circle one Diesel Engine Gasoline Engine Natural Gas	
Bucket Piston Turbine	Electric Motor Hand Tractor PTO	
Centrifugal Rotary Flowing Well	Windmill Other (specify):	
Other (specify):	Horse Power Rating of Motor:	
Date Pump Installed: <u>5-23-13.</u>	Setting Depth: 100 <sup>-</sup> feet	
Rated Pump Capacity:Gallons Per Minute	Number of Stages: <u>(2</u>	
	· · · · · · · · · · · · · · · · · · ·	
Pump Test Data Date Well Tested:	Method of Measuring Water Level Circle one	
	Air Line Electric Measuring Line Steel Tape)	
Static Water Level (A):Feet Below Land Surface		
Pumping Water Level (B):Feet Below Land Surface	Other (specify):	
Drawdown [(B) – (A)]:Feet Below Land Surface	For flowing well, measured shut in head:feet	
Test Pumping Rate:Gallons Per Minute	Well yielded GPM with a drawdown of	
Duration of Pump Test (minimum 4 hours):hours	feet afterhours of pumping	
This is for (circle one): New Well Replacement of Existing Pump Repair of Existing Pump RECEIVE		
I HEREBY CERTIFY that the above statements are true to the best of my knowledge.		
Bigd Flageald 029. Buttall By Colore		
Print Name of Pamp Installer and License No. (if applicable)	Signature of Pump Installer	
THE FUEL OF THE HOUSE AND LIVERSE TO THE APPROADE	Form: OLWR-SWR-1C (07-09)	

4-- 5