

Pike
 D 2000
 8-25-75

MISSISSIPPI
 BOARD OF WATER COMMISSIONERS
 416 North State Street
 Jackson, Mississippi 39201

WATER WELL DRILLERS LOG

Aug 25 19 75 *Beems Well Service* *Pike*
 date well completed firm name county well located

LANDOWNER:
Willie Green
Harry 24 McComb
 (mailing address)


description of formations encountered	from	to
<i>Sand clay</i>	<i>0</i>	<i>20</i>
<i>Red sand</i>	<i>20</i>	<i>68</i>
<i>Plow ground</i>	<i>68</i>	<i>79</i>
<i>Hard</i>		

WELL LOCATION:
 sec. *14* T *3* N R *7* E
in City miles *1* of *McComb*
 (distance) (direction) (nearest town)

WELL PURPOSE: *Dom*
 (home, irrigation, municipal, industrial)

- WELL COMPLETION DATA:
- (1) diameter (inches) *4"*
 - (2) total depth (feet) *79*
 - (3) static water level (feet) *60* below top of ground.
 - (4) casing *plastic bottom*
 (material) (depth)
 - (size) If telescope see back.
 - (5) screen *6"* *73'*
 (length) (depth to top)
 - 4"* *plastic*
 (size) (material)
 - (6) pump *1/2* (HP) *6* (yield gpm)
 - elect*
 (type power)
 - (7) electric log *no*
 (yes or no)
 - (organization running log)
 - (8) how well bottom plugged
Wooden plug

DRILLERS REMARKS:
5" Well plugged out

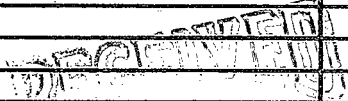


JAN 12 1976

MISSISSIPPI BOARD OF WATER COMMISSIONERS

If well telescopes please sketch and show depths.

GROUND LEVEL

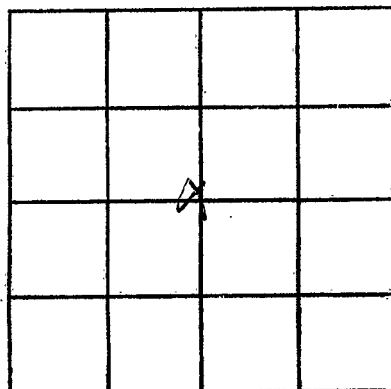

SECTION 14

Please indicate well location X.

ADDITIONAL INFORMATION

If more than one screen,
show locations of each on sketch.