

Pike  
 D 2001  
 9-16-75

MISSISSIPPI  
 BOARD OF WATER COMMISSIONERS  
 416 North State Street  
 Jackson, Mississippi 39201

WATER WELL DRILLERS LOG

Sept 16 1975 Pearce Well Ser Pike  
 date well completed firm name county well located

LANDOWNER:  
Jeff Smith  
Hwy 48 - McComb  
 (mailing address)

description of formations encountered	from	to
<u>Red Clay</u>	<u>0</u>	<u>10</u>
<u>Red sand gravel</u>	<u>10</u>	<u>80</u>
<u>pink Chalk</u>	<u>80</u>	<u>95</u>
<u>Shalt per ground</u>	<u>95</u>	<u>112</u>


WELL LOCATION:  
 sec 28 T 3 N R 7 E  
1 miles North of Pinney  
 (distance) (direction) (nearest town)

WELL PURPOSE: Tractor  
 (home, irrigation, municipal, industrial)

- WELL COMPLETION DATA:
- (1) diameter (inches) 4"
  - (2) total depth (feet) 112
  - (3) static water level (feet) 75 below top of ground.
  - (4) casing plastic bottom  
 (material) (depth)
  - (size) If telescope see back.
  - (5) screen 6' 106  
 (length) (depth to top)
  - 4" plastic  
 (size) (material)
  - (6) pump 1/2 Sub 10  
 (HP) (yield gpm)
  - elect  
 (type power)
  - (7) electric log no  
 (yes or no)
  - (organization running log)

(8) how well bottom plugged  
not plugged


DRILLERS REMARKS:  
new location

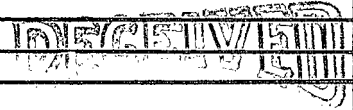

JAN 2 1976

If well telescopes please sketch and show depths.

GROUND LEVEL

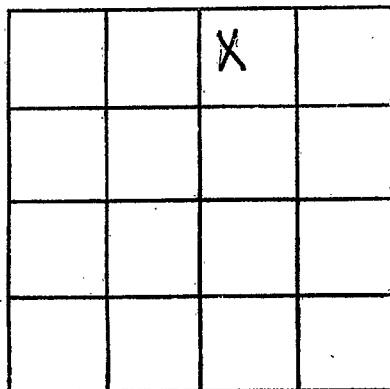

SECTION 28

Please indicate well location X.

ADDITIONAL INFORMATION

If more than one screen,  
show locations of each on sketch.