

Pike
 D 2002
 10-18-75

MISSISSIPPI
 BOARD OF WATER COMMISSIONERS
 416 North State Street
 Jackson, Mississippi 39201

WATER WELL DRILLERS LOG

Oct-18 1975 *Reynolds Well Service* *Pike*
 date well completed firm name county well located

LANDOWNER:
Andrew Watson
Fleming
 (mailing address)

description of formations encountered	from	to
<i>Red Clay</i>	<i>0</i>	<i>18</i>
<i>White Chalk</i>	<i>18</i>	<i>30</i>
<i>Small gravel sand</i>	<i>30</i>	<i>70</i>
<i>limestone</i>	<i>70</i>	<i>90</i>
<i>Small open gravel</i>	<i>90</i>	<i>105</i>

WELL LOCATION:
 sec *34* T *3* N R *7* E
3 miles *N-NW* of *Magnolia*
 (distance) (direction) (nearest town)

WELL PURPOSE: *house*
 (home, irrigation, municipal, industrial)

- WELL COMPLETION DATA:
- (1) diameter (inches) *4"*
 - (2) total depth (feet) *105*
 - (3) static water level (feet) *69* below top of ground
 - (4) casing *plastic bottom*
 (material) (depth)
 - 1* if telescope see back.
 (size)
 - (5) screen *6'* *99*
 (length) (depth to top)
 - 4"* *plastic*
 (size) (material)
 - (6) pump *3/4 HP* *6*
 (type power) (yield gpm)
 - (7) electric log *no*
 (yes or no)
- (organization running log)


(8) how well bottom plugged
wood plug

DRILLERS REMARKS:
2" plastic pipe
cut back

RECEIVED
 JAN 12 1975
 WATER COMMISSION

If well telescopes please sketch and show depths.

GROUND LEVEL

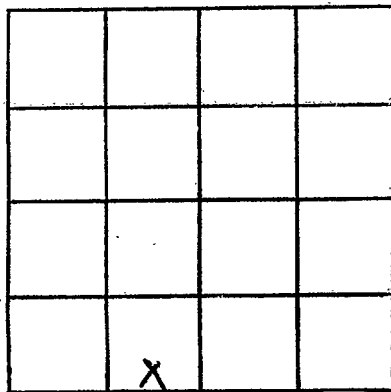

SECTION 34

Please indicate well location X.

ADDITIONAL INFORMATION

If more than one screen,
show locations of each on sketch.