

Pike
D 2003
10-25-75

MISSISSIPPI
BOARD OF WATER COMMISSIONERS
416 North State Street
Jackson, Mississippi 39201

WATER WELL DRILLERS LOG

Oct 95
date well completed

1975 *Pike*
firm name

Pike
county well located

LANDOWNER:

Walter Williams

RT1 Magnolia
(mailing address)

WELL LOCATION:

sec. 33 T 3 N R 7 E

$\frac{1}{2}$ miles East of Amory
(distance) (direction) (nearest town)

WELL PURPOSE:

Dom.
(home, irrigation, municipal, industrial)

WELL COMPLETION DATA:

- (1) diameter (inches) 4"
- (2) total depth (feet) 103
- (3) static water level (feet) 80 below above top of ground.
- (4) casing plastic bottom
(material) (depth)
- 1 If telescope see back.
(size)
- (5) screen 6" 107
(length) (depth to top)
- 4" plastic
(size) (material)
- (6) pump 1/2 Sub 10
(HP) (yield gpm)
- split
(type power)
- (7) electric log no
(yes or no)

(organization running log)

(8) how well bottom plugged

Wooden Plug


DRILLERS REMARKS:

new house site

description of formations encountered

from to

<i>Red Clay</i>	<i>0</i>	<i>15</i>
<i>Red sand</i>	<i>15</i>	<i>30</i>
<i>gravel & sand</i>	<i>30</i>	<i>60</i>
<i>pink chalk</i>	<i>60</i>	<i>80</i>
<i>sand & small gravel</i>	<i>80</i>	<i>103</i>

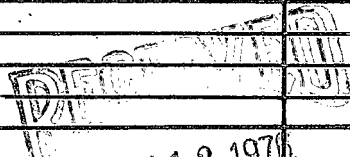


JAN 12 1976

MISS. Bd. OF WATER COMMISSIONERS

If well telescopes please sketch and show depths.

GROUND LEVEL

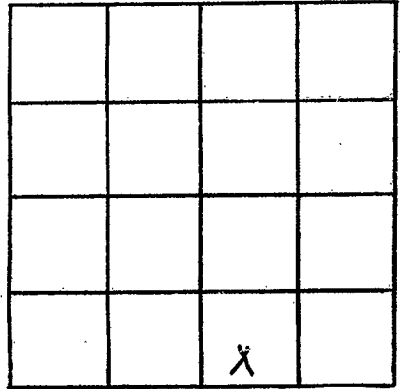

SECTION 33

Please indicate well location X.

ADDITIONAL INFORMATION

If more than one screen,
show locations of each on sketch.