

Pike
 D 2004
 9-22-76

MISSISSIPPI
 BOARD OF WATER COMMISSIONERS
 416 North State Street
 Jackson, Mississippi 39201

WATER WELL DRILLERS LOG

Sept 22 1976 *Rumsey* Pike
 date well completed firm name county well located

LANDOWNER:	description of formations encountered	from	to
<i>Bill Richardson</i>			
<i>P.O. box McComb</i> (mailing address)	<i>clay</i>	<i>0</i>	<i>30</i>
WELL LOCATION: sec. <i>5</i> T. <i>3</i> N R. <i>7</i> E <i>2 1/2</i> miles <i>west</i> of <i>McComb</i> (distance) (direction) (nearest town)	<i>Red sand</i>	<i>30</i>	<i>60</i>
WELL PURPOSE: <i>Home</i> (home, irrigation, municipal, industrial)	<i>Clay sub + gravel</i>	<i>60</i>	<i>80</i>
WELL COMPLETION DATA: (1) diameter (inches) <i>4"</i>	<i>solid pea gravel</i>	<i>80</i>	<i>122</i>
(2) total depth (feet) <i>122</i>			
(3) static water level (feet) <i>65</i> below above top of ground.			
(4) casing <i>plastic bottom</i> (material) (depth)			
(5) screen <i>6"</i> <i>116</i> (length) (depth to top)			
(6) pump <i>4"</i> <i>plastic</i> (size) (material)			
(7) electric log <i>no</i> (yes or no)			
(8) how well bottom plugged <i>wooden plug</i>			
DRILLERS REMARKS:			


RECEIVED

DEC 8 1976

MISS. Bd. OF WATER COMMISSIONERS

If well telescopes please sketch and show depths.

GROUND LEVEL

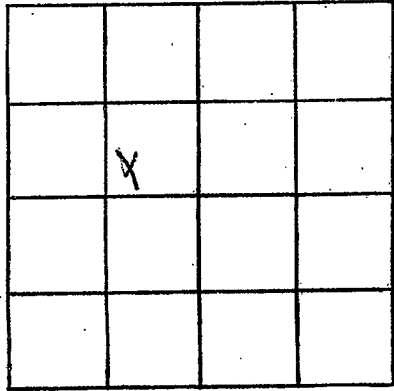

SECTION 5

Please indicate well location X.

ADDITIONAL INFORMATION

If more than one screen, show locations of each on sketch.