

Pike
 D 2005
 2-5-76

MISSISSIPPI
 BOARD OF WATER COMMISSIONERS
 416 North State Street
 Jackson, Mississippi 39201

WATER WELL DRILLERS LOG

2-5
 date well completed

1976
 firm name


Pike
 county well located

LANDOWNER:	description of formations encountered	from	to
But Bradford	Red clay	0	20
R.B. McComb (mailing address)	Red sand	20	40
	Coarse sand & gravel	40	96
WELL LOCATION:			
sec 28 T 3 N R 7 E S W			
3 miles SW of McComb (distance) (direction) (nearest town)			
WELL PURPOSE: Home (home, irrigation, municipal, industrial)			
WELL COMPLETION DATA:			
(1) diameter (inches) 4			
(2) total depth (feet) 96			
(3) static water level (feet) 55 below above top of ground.			
(4) casing PVC, 88, (material) (depth)			
4 (size) if telescope see back.			
(5) screen 2, 88 (length) (depth to top)			
4, PVC (size) (material)			
(6) pump 3/4, 15 (HP) (yield gpm)			
Elec (type power)			
(7) electric log no (yes or no)			
(organization running log)			
(8) how well bottom plugged Sand Shale			
DRILLERS REMARKS:			

REGISTERED
 APR - 7 1976

If well telescopes please sketch and show depths.

GROUND LEVEL

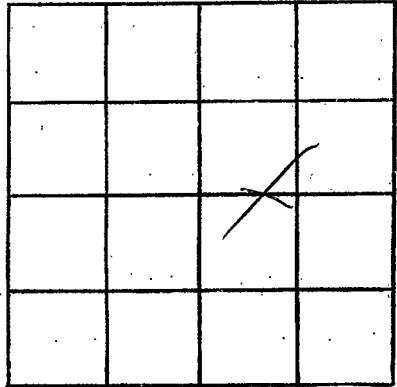

SECTION 28

Please indicate well location X.

ADDITIONAL INFORMATION

If more than one screen, show locations of each on sketch.