

Pike
 D 2006
 2-27-76

MISSISSIPPI
 BOARD OF WATER COMMISSIONERS
 416 North State Street
 Jackson, Mississippi 39201

WATER WELL DRILLERS LOG


2-27 1976 Fitzgerald Well Serv Pike
 date well completed firm name county well located

LANDOWNER:	description of formations encountered	from	to
<u>Seaga Enterprises</u>			
<u>R.R. McComb, Miss.</u> (mailing address)	<u>Red clay</u>	<u>6</u>	<u>20</u>
	<u>Red sand</u>	<u>20</u>	<u>60</u>
	<u>White + Blk chalk</u>	<u>60</u>	<u>115</u>
	<u>Coarse sand + gravel</u>	<u>115</u>	<u>130</u>
WELL LOCATION:			
sec. <u>35</u> T. <u>3</u> N. R. <u>7</u> E. S. <u>1</u> W.			
<u>3</u> miles <u>S</u> of <u>McComb</u> (distance) (direction) (nearest town)			
WELL PURPOSE: <u>Home use</u> (home, irrigation, municipal, industrial)			
WELL COMPLETION DATA:			
(1) diameter (inches) <u>4</u>			
(2) total depth (feet) <u>130</u>			
(3) static water level (feet) <u>75</u> below top of ground.			
(4) casing <u>PVC</u> , <u>122</u> , (material) (depth)			
<u>4</u> If telescope see back. (size)			
(5) screen <u>8</u> , <u>122</u> (length) (depth to top)			
<u>4</u> , <u>PVC</u> (size) (material)			
(6) pump <u>1</u> , <u>22</u> (HP) (yield gpm)			
<u>Elco</u> (type power)			
(7) electric log <u>no</u> (yes or no)			
(organization running log)			
(8) how well bottom plugged <u>Seal slink</u>			
DRILLERS REMARKS:			

RECEIVED
 APR 7 1976
 MISS. BD. OF WATER COMMISSIONERS

If well telescopes please sketch and show depths.

GROUND LEVEL

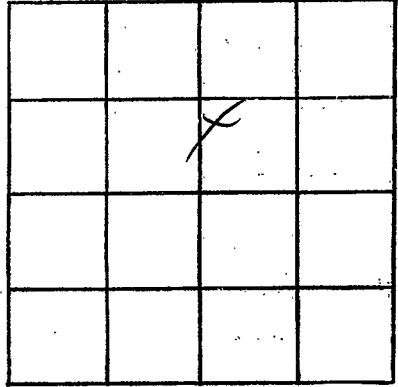

SECTION 35

Please indicate well location X.

ADDITIONAL INFORMATION

If more than one screen, show locations of each on sketch.