


Pike  
D 2009  
4-20-76

MISSISSIPPI  
 BOARD OF WATER COMMISSIONERS  
 416 North State Street  
 Jackson, Mississippi 39201

WATER WELL DRILLERS LOG


4-20 <sup>14H</sup> 76 Fitzgerald Well Serv Pike  
 date well completed firm name county well located

| LANDOWNER:  | description of formations encountered | from | to |
|---|---------------------------------------|------|----|
| <u>Dave Reed</u><br><u>R.R. MCT</u><br>(mailing address)  |                                       |      |    |
| WELL LOCATION:<br>sec. <u>28</u> T. <u>3</u> N R. <u>7</u> E<br>S W<br><u>6</u> miles <u>w</u> of <u>Mcb</u><br>(distance) (direction) (nearest town) |                                       |      |    |
| WELL PURPOSE: <u>Home</u><br>(home, irrigation, municipal, industrial)  |                                       |      |    |
| WELL COMPLETION DATA:   |                                       |      |    |
| (1) diameter (inches) <u>4</u>  |                                       |      |    |
| (2) total depth (feet) <u>82</u>  |                                       |      |    |
| (3) static water level (feet) <u>70</u> below<br>top of ground.   |                                       |      |    |
| (4) casing <u>PVC</u> , <u>74</u> ,<br>(material) (depth)<br><u>4</u> if telescope see back.<br>(size)  |                                       |      |    |
| (5) screen <u>84</u> , <u>74</u><br>(length) (depth to top)   |                                       |      |    |
| (6) pump <u>3/4</u> , <u>PVC</u><br>(HP) (yield gpm)<br><u>alt</u><br>(type power)  |                                       |      |    |
| (7) electric log <u>no</u><br>(yes or no)<br>(organization running log)   |                                       |      |    |
| (8) how well bottom plugged <u>sealed</u>   |                                       |      |    |
| DRILLERS REMARKS:   |                                       |      |    |

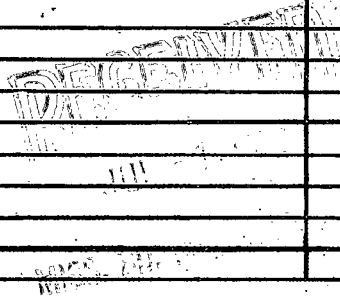

If well telescopes please sketch and show depths.

GROUND LEVEL

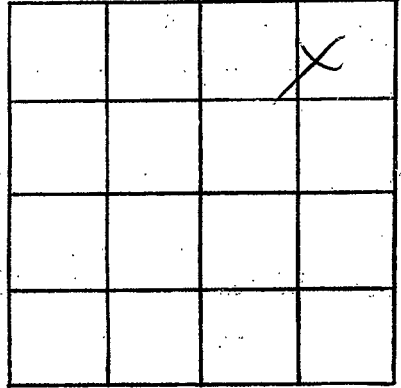

SECTION 28

Please indicate well location X.

ADDITIONAL INFORMATION

If more than one screen, show locations of each on sketch.