

Pike
D 2010
4-28-76

MISSISSIPPI
 BOARD OF WATER COMMISSIONERS
 416 North State Street
 Jackson, Mississippi 39201

WATER WELL DRILLERS LOG


4-28 ^{14H} 1976 Fitzgerald Pike
 date well completed firm name county well located

LANDOWNER:	description of formations encountered	from	to
<u>Bob Hensarkin</u>			
<u>RR. m. l. b. Miss.</u> (mailing address)	<u>Red. clay</u> <u>Red sand</u> <u>Coarse sand & gravel</u>	<u>0</u> <u>70</u> <u>85</u>	<u>20</u> <u>85</u> <u>100</u>
WELL LOCATION:			
sec. <u>28</u> T. <u>3</u> N. R. <u>7</u> E. <u>6</u> miles <u>SW</u> of <u>m. l. b.</u> (distance) (direction) (nearest town)			
WELL PURPOSE: (home, irrigation, municipal, industrial)			
WELL COMPLETION DATA:			
(1) diameter (inches) <u>4</u>			
(2) total depth (feet) <u>100</u>			
(3) static water level (feet) <u>55</u> below above top of ground.			
(4) casing <u>PVC</u> , <u>92</u> , (material) (depth) <u>4</u> if telescope see back. (size)			
(5) screen <u>8</u> , <u>92</u> (length) (depth to top)			
<u>4</u> , <u>PVC</u> (size) (material)			
(6) pump <u>3/4</u> , <u>15</u> (HP) (yield gpm)			
<u>cb</u> (type power)			
(7) electric log <u>no</u> (yes or no)			
<u>no</u> (organization running log)			
(8) how well bottom plugged <u>solid</u>			
DRILLERS REMARKS:			

JUL 1 1976
 MISSISSIPPI BOARD OF WATER COMMISSIONERS

If well telescopes please sketch and show depths.

GROUND LEVEL

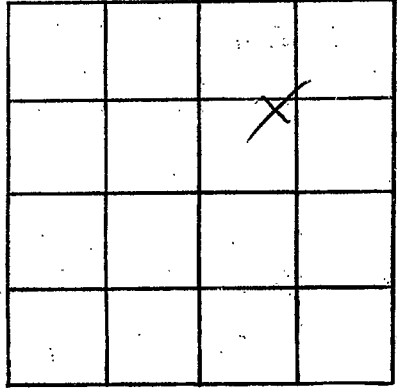

SECTION 28

Please indicate well location X.

ADDITIONAL INFORMATION

If more than one screen, show locations of each on sketch.