

Pike
 D 2011
 7-27-76

MISSISSIPPI
 BOARD OF WATER COMMISSIONERS
 416 North State Street
 Jackson, Mississippi 39201

WATER WELL DRILLERS LOG

Hidgcraft Well Service
 Larry Seago
 14H 1976

7-27

date well completed

firm name

county well located

LANDOWNER:	description of formations encountered	from	to
Larry Seago P.O. McComb, Miss. (mailing address)			
WELL LOCATION:			
sec. 28 T. 3 N. R. 7 E S S W W			
5 miles W of McComb (distance) (direction) (nearest town)			
WELL PURPOSE: Home (home, irrigation, municipal, industrial)			
WELL COMPLETION DATA:			
(1) diameter (inches) 4"			
(2) total depth (feet) 111			
(3) static water level (feet) 75 below top of ground.			
(4) casing PVC, 103, (material) (depth) 4 (size) if telescope see back.			
(5) screen 8, 103 (length) (depth to top) 4 (size) PVC (material)			
(6) pump 1/2, 20 (HP) (yield gpm) Elec (type power)			
(7) electric log No (yes or no) (organization running log)			
(8) how well bottom plugged Sand block			
DRILLERS REMARKS:			


RECEIVED

AUG 20 1976

MISS. BD. OF WATER COMM

If well telescopes please sketch and show depths.

GROUND LEVEL

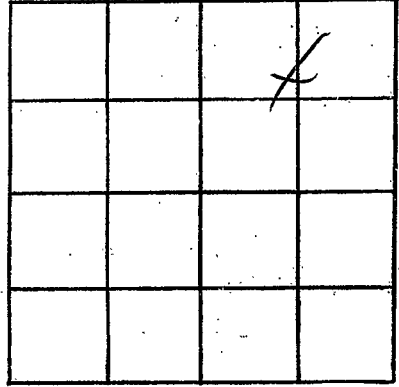

SECTION 28

Please indicate well location X.

ADDITIONAL INFORMATION

If more than one screen, show locations of each on sketch.