

Pike
D 2012
8-24-76

MISSISSIPPI
 BOARD OF WATER COMMISSIONERS
 416 North State Street
 Jackson, Mississippi 39201

WATER WELL DRILLERS LOG

8-24
 date well completed

1976 Fitzgerald Lumber Service
 firm name

Pike
 county well located


LANDOWNER:	description of formations encountered	from	to
<u>Donnie Collins</u>			
<u>RR Summit, Miss</u> (mailing address)	<u>Red clay</u>	<u>0</u>	<u>20</u>
	<u>Red sand</u>	<u>20</u>	<u>80</u>
	<u>white chalk</u>	<u>80</u>	<u>135</u>
	<u>Coarse sand & gravel</u>	<u>135</u>	<u>150</u>
WELL LOCATION:			
sec. <u>9</u> T. <u>3</u> (N) R. <u>7</u> (E)			
<u>2</u> miles <u>W</u> of <u>McComb</u> (distance) (direction) (nearest town)			
WELL PURPOSE:			
(home, irrigation, municipal, industrial) <u>Home</u>			
WELL COMPLETION DATA:			
(1) diameter (inches) <u>4</u>			
(2) total depth (feet) <u>150</u>			
(3) static water level (feet) <u>75</u> below above top of ground.			
(4) casing <u>PVC</u> , <u>142</u> (material) (depth)			
<u>4</u> If telescope see back. (size)			
(5) screen <u>8</u> , <u>142</u> (length) (depth to top)			
<u>4</u> , <u>PVC</u> (size) (material)			
(6) pump <u>1/2</u> , <u>10</u> (HP) (yield gpm)			
<u>elec</u> (type power)			
(7) electric log <u>no</u> (yes or no)			
(organization running log)			
(8) how well bottom plugged <u>Sand shank</u>			
DRILLERS REMARKS:			

RECEIVED
 OCT 18 1976

MISS. BD OF WATER CONTROL

If well telescopes please sketch and show depths.

GROUND LEVEL

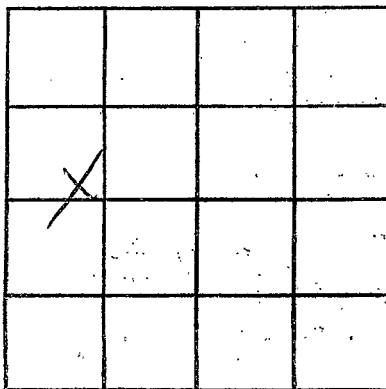

SECTION 9

Please indicate well location X.

ADDITIONAL INFORMATION

If more than one screen, show locations of each on sketch.