

Pike
D 2013
10-8-76

MISSISSIPPI
BOARD OF WATER COMMISSIONERS
416 North State Street
Jackson, Mississippi 39201

WATER WELL DRILLERS LOG

10-8-76 ¹⁴⁴ 1976 *Flynnwell Inc* Pike
date well completed firm name county well located


LANDOWNER:
Riverside Estates
R.R. McComb
(mailing address)

description of formations encountered	from	to
<u>Red Clay</u>	<u>0</u>	<u>20</u>
<u>Red sand</u>	<u>20</u>	<u>80</u>
<u>Coarse sand & gravel</u>	<u>80</u>	<u>100</u>
<u>Red sand</u>	<u>100</u>	<u>123</u>
<u>Coarse sand & gravel</u>	<u>123</u>	<u>132</u>

WELL LOCATION:
sec 28 T. 3 (N) R. 07 (E)
3 miles W of McComb
(distance) (direction) (nearest town)

WELL PURPOSE:
Home
(home, irrigation, municipal, industrial)

- WELL COMPLETION DATA:
- (1) diameter (inches) 4
 - (2) total depth (feet) 132
 - (3) static water level (feet) 65 below top of ground.
 - (4) casing PVC (material), 124 (depth)
4 (size) 1" telescope see back.
 - (5) screen 2 1/8 (length), 124 (depth to top)
4 (size), PVC (material)
 - (6) pump 5 (HP), 90 (yield gpm)
Electric (type power)
 - (7) electric log no (yes or no)
(organization running log)
 - (8) how well bottom plugged sand plug

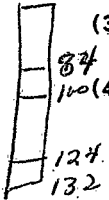


RECEIVED
OCT 28 1976
MISS. BOARD OF WATER COMMISSIONERS

DRILLERS REMARKS:

If well telescopes please sketch and show depths.

GROUND LEVEL

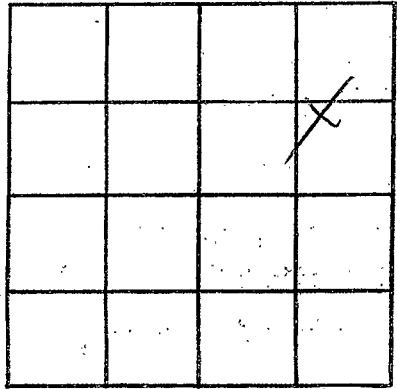

SECTION 28

Please indicate well location X:

ADDITIONAL INFORMATION

If more than one screen, show locations of each on sketch.