

Pike  
 D 2014  
 10/19/76

MISSISSIPPI  
 BOARD OF WATER COMMISSIONERS  
 416 North State Street  
 Jackson, Mississippi 39201

WATER WELL DRILLERS LOG


Oct 19 1976 *Reuss-Wilser* *Pike*  
 date well completed firm name county well located

LANDOWNER:	description of formations encountered	from	to
<i>Percy Barnes</i> <i>R. F. Magnolia</i> (mailing address)			
WELL LOCATION: sec <i>34</i> T <i>3</i> N R <i>7</i> E <i>2</i> miles <i>N-NW</i> of <i>Magnolia</i> (distance) (direction) (nearest town)			
WELL PURPOSE: <i>Home</i> (home, irrigation, municipal, industrial)			
WELL COMPLETION DATA: (1) diameter (inches) <i>4"</i> (2) total depth (feet) <i>112</i> (3) static water level (feet) <i>65</i> below above top of ground (4) casing <i>plastic</i> (material) <i>bottom</i> (depth) (size) if telescope see back. (5) screen <i>6"</i> (length) <i>106</i> (depth to top). (size) <i>4"</i> (material) <i>plastic</i> (6) pump <i>1/2</i> (HP) <i>10</i> (yield gpm) (type power) <i>electric</i> (7) electric log <i>no</i> (yes or no) (organization running log) (8) how well bottom plugged <i>water plug</i>			
DRILLERS REMARKS:			

RECEIVED  
 FEB 4 1977

If well telescopes please sketch and show depths.

GROUND LEVEL

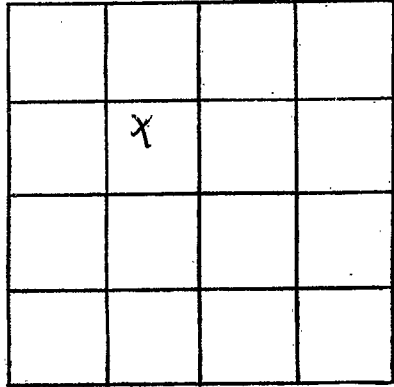

SECTION 34

Please indicate well location X.

ADDITIONAL INFORMATION

If more than one screen, show locations of each on sketch.