

PIKE

D 2015

2-16-77

MISSISSIPPI BOARD OF WATER COMMISSIONERS
416 North State Street
Jackson, Mississippi 39201

15

WATER WELL DRILLERS LOG

Feb-16 1977
date well completed

144
Aceman Well Co
firm name

Pike
county well located

LANDOWNER:

J. B. Robinson
RT 3 M. J. Couch
(mailing address)

description of formations encountered

from to

Red Clay	0	18
Red sand	18	50
sandy clay	50	80
sandy gravel	80	95
ch. bl. s.	95	110
sand & gravel	110	124

WELL LOCATION:

sec. 23 T 3 N R 7 E
1 miles west of N. Cove
(distance) (direction) (nearest town)

WELL PURPOSE: Drinking
(home, irrigation, municipal, industrial)

WELL COMPLETION DATA:

- (1) diameter (inches) 4"
- (2) total depth (feet) 124
- (3) static water level (feet) 80 below top of ground.
- (4) casing plastic bottom
(material) (depth)
- (size) if telescope see back.
- (5) screen 5' 119'
(length) (depth to top)
- (size) 1 1/2" plastic
(size) (material)
- (6) pump weather
(HP) (yield gpm)
- (type power) elect
- (7) electric log no
(yes or no)

(organization running log)

(8) how well bottom plugged

was plugged


DRILLERS REMARKS:

RECEIVED
MAR 21 1977

MISS. Bd. of WATER COMM.

If well telescopes please sketch and show depths.

GROUND LEVEL

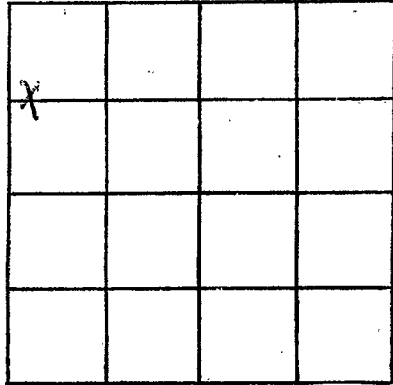

SECTION 23

Please indicate well location X.

ADDITIONAL INFORMATION

If more than one screen,
show locations of each on sketch.