

Pike  
 D 2018  
 5/5/77

MISSISSIPPI  
 BOARD OF WATER COMMISSIONERS  
 416 North State Street  
 14th Jackson, Mississippi 39201

WATER WELL DRILLERS LOG

MAY 5 1977 Coulington Pike  
 date well completed firm name county well located

LANDOWNER: Lee S. McMorris  
McComb, Miss  
 (mailing address)

description of formations encountered	from	to
CLAY	0	23
SAND & CLAY	23	65
SAND + GRAVEL	65	85
CLAY	85	95
SAND + ROCKS	95	121

WELL LOCATION:  
 sec. 31 T. 3 N R. 7 E  
5 miles SW of McComb  
 (distance) (direction) (nearest town)

WELL PURPOSE: Home  
 (home, irrigation, municipal, industrial)

- WELL COMPLETION DATA:
- (1) diameter (inches) 4
  - (2) total depth (feet) 121
  - (3) static water level (feet) 95' below above top of ground.
  - (4) casing Plastic 114  
 (material) (depth)
  - 4 if telescope see back.  
 (size)
  - (5) screen 7 114  
 (length) (depth to top)
  - 4 Plastic  
 (size) (material)
  - (6) pump 3/4 10  
 (HP) (yield gpm)
  - (type power)
  - (7) electric log (yes or no)
  - (organization running log)
  - (8) how well bottom plugged Wood


DRILLERS REMARKS:

RECEIVED  
 JUN 20 1977

MISS. BD. OF WATER COMMISSIONERS

If well telescopes please sketch and show depths.

GROUND LEVEL

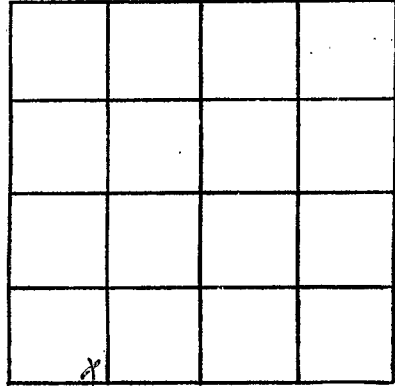

SECTION \_\_\_\_\_

Please indicate well location X.

ADDITIONAL INFORMATION

If more than one screen,  
show locations of each on sketch.