

Pike
 D 201A
 5/6/77

MISSISSIPPI
 BOARD OF WATER COMMISSIONERS
 416 North State Street
 Jackson, Mississippi 39201

WATER WELL DRILLERS LOG

14H
 MAY 6 1977 Covington Pike
 date well completed firm name county well located

LANDOWNER: Gary Felder
 Summit Miss
 (mailing address)

WELL LOCATION:
 sec. 28 T 3 N R 7 E
 2 miles SW of McComb
 (distance) (direction) (nearest town)

WELL PURPOSE: home
 (home, irrigation, municipal, industrial)

WELL COMPLETION DATA:
 (1) diameter (inches) 4
 (2) total depth (feet) 94
 (3) static water level (feet) 82 below above top of ground.
 (4) casing Plastic 87 (material) (depth)
 4" (size) if telescope see back.
 (5) screen 7 87 (length) (depth to top)
 4 Plastic (size) (material)
 (6) pump Mr (HP) 4 (yield gpm)
 (type power)
 (7) electric log (yes or no)
 (organization running log)
 (8) how well bottom plugged Wood

description of formations encountered	from	to
CLAY	0	21
SANDY CLAY	21	47
SAND & GRAVEL	47	67
CLAY	67	75
SAND	75	94


DRILLERS REMARKS:

RECEIVED
 JUN 20 1977

MISS. BD. OF WATER COMMISSIONERS

If well telescopes please sketch and show depths.

GROUND LEVEL

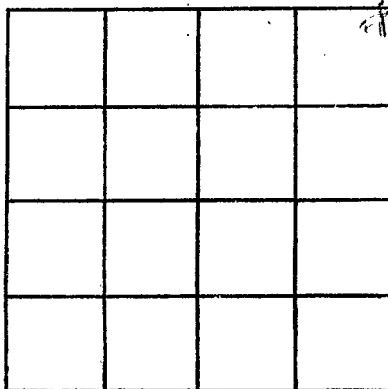

SECTION 28

Please indicate well location X.

ADDITIONAL INFORMATION

If more than one screen, show locations of each on sketch.