

Pike
 D 2020
 5/18/77

MISSISSIPPI
 BOARD OF WATER COMMISSIONERS
 416 North State Street
 Jackson, Mississippi 39201

4#

WATER WELL DRILLERS LOG

May 18 - 77 19 Reuss Well Co Pike
 date well completed firm name county well located

LANDOWNER:
Mr. Price Wilkinson
Pine Hurst Drive
 (mailing address)
McComb
 sec. 21 T-3 N R-7 E
2 miles West of McComb
 (distance) (direction) (nearest town)

description of formations encountered	from	to
<u>Red Clay</u>	<u>0</u>	<u>22</u>
<u>Red sand</u>	<u>22</u>	<u>60</u>
<u>pink chalk</u>	<u>60</u>	<u>95</u>
<u>well ground</u>		
<u>Red sand</u>	<u>95</u>	<u>114</u>

WELL PURPOSE: house
 (home, irrigation, municipal, industrial)

WELL COMPLETION DATA:

(1) diameter (inches) 4

(2) total depth (feet) 114

(3) static water level (feet) 75 below above top of ground

(4) casing plastic bottom
 (material) (depth)

(size) if telescope see back.

(5) screen 5' 109
 (length) (depth to top)

4" plastic
 (size) (material)

(6) pump Sub 10
 (HP) (yield gpm)

elect
 (type power)

(7) electric log no
 (yes or no)

(organization running log)

(8) how well bottom plugged
wooden plug


DRILLERS REMARKS:

RECEIVED
 JUN 21 1977

MISS. BD. OF WATER COMMISSIONERS

If well telescopes please sketch and show depths.

GROUND LEVEL

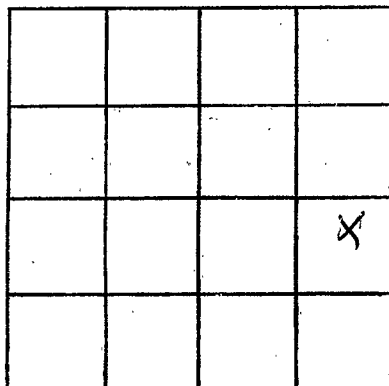

SECTION 21

Please indicate well location X.

ADDITIONAL INFORMATION

If more than one screen,
show locations of each on sketch.