

Pike
D 2021
6-27-77

MISSISSIPPI
 BOARD OF WATER COMMISSIONERS
 416 North State Street
 Jackson, Mississippi 39201

WATER WELL DRILLERS LOG

6-27 1977 Fitzgerald Well Service Pike
 date well completed firm name county well located

LANDOWNER:
Brent Clayton
R.R. Dasher 2766, Miss
 (mailing address)

description of formations encountered	from	to
<u>Red clay</u>	<u>0</u>	<u>20</u>
<u>Red sand</u>	<u>20</u>	<u>80</u>
<u>White chalk</u>	<u>80</u>	<u>110</u>
<u>Coarse sand & gravel</u>	<u>110</u>	<u>120</u>

WELL LOCATION:
 sec. 21 T. 3 (N) R. 2 (E)
2 miles W of Baytown
 (distance) (direction) (nearest town)

WELL PURPOSE:
Home
 (home, irrigation, municipal, industrial)


- WELL COMPLETION DATA:
- (1) diameter (inches) 4
 - (2) total depth (feet) 120
 - (3) static water level (feet) 80 below above top of ground.
 - (4) casing PVC, 112,
 (material) (depth)
4 if telescope see back.
 (size)
 - (5) screen 8, 112
 (length) (depth to top)
4, PVC
 (size) (material)
 - (6) pump 3/4, 15
 (HP) (yield gpm)
Electric
 (type power)
 - (7) electric log No
 (yes or no)
 (organization running log)
 - (8) how well bottom plugged Sand plug

RECEIVED
 AUG 29 1977

DRILLERS REMARKS:

If well telescopes please sketch and show depths.

GROUND LEVEL

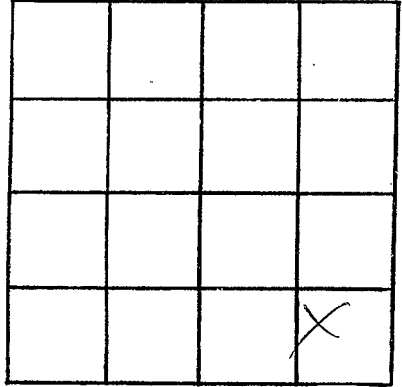

SECTION 21

Please indicate well location X.

ADDITIONAL INFORMATION

If more than one screen, show locations of each on sketch.